

ADDENDUM 1 WEST JACKSON COUNTY UTILITY DISTRICT AMI SYSTEM IMPROVEMENTS

Date: Wednesday, November 16, 2022

Project #: 0225.21.004

Project Name: AMI System Improvements
7200 McCann Road
Biloxi, MS 39532

Owner: West Jackson County Utility District
7200 McCann Road
Biloxi, MS 39532

To: All Prospective Bidders

From: Jason Polite, P.E.

Bidders are hereby informed that the Project Manual and Drawings are modified as follows:

This Addendum forms a part of the Contract Documents and modifies the original Bidding Documents with a submittal date of October 14, 2022. It is the General Contractor's responsibility for providing proper acknowledgement and receipt of this Addendum in the Bid Forms/Document.

Attachments to this Addendum: As described herein.

Total Number of Pages in this Addendum: 3 Pages

PART A: GENERAL ADDENDUM, BIDDING, AND/OR PROJECT NOTES:

A1. None this addendum.

PART B: CONTRACTOR QUESTIONS WITH RESPONSES (Responses are in RED)

Note: If you do not see your question answered, then we are still researching or working on a solution.

B1. None this addendum.

PART C: SPECIFICATION CLARIFICATIONS, REVISIONS, AND ADDITIONS:

C1. None this addendum.

PART D: DRAWING CLARIFICATIONS, REVISIONS, AND ADDITIONS:


D1. C620: Replace this sheet in its entirety with the attached. Revisions have been clouded.

PART E: APPROVED PRODUCT/VENDOR EQUALS


E1. None this addendum.

END OF ADDENDUM 1


PRINTED: 11/16/2022 8:30 AM BY: Jason Polite LAST SAVED: 11/16/2022 8:29 AM BY: jpolite
 m:\0225_west_jackson_county_utility_district\0225.21.004_radio_tower_site_engineering\02-civil\03-production drawings\radio tower site plans.dwg

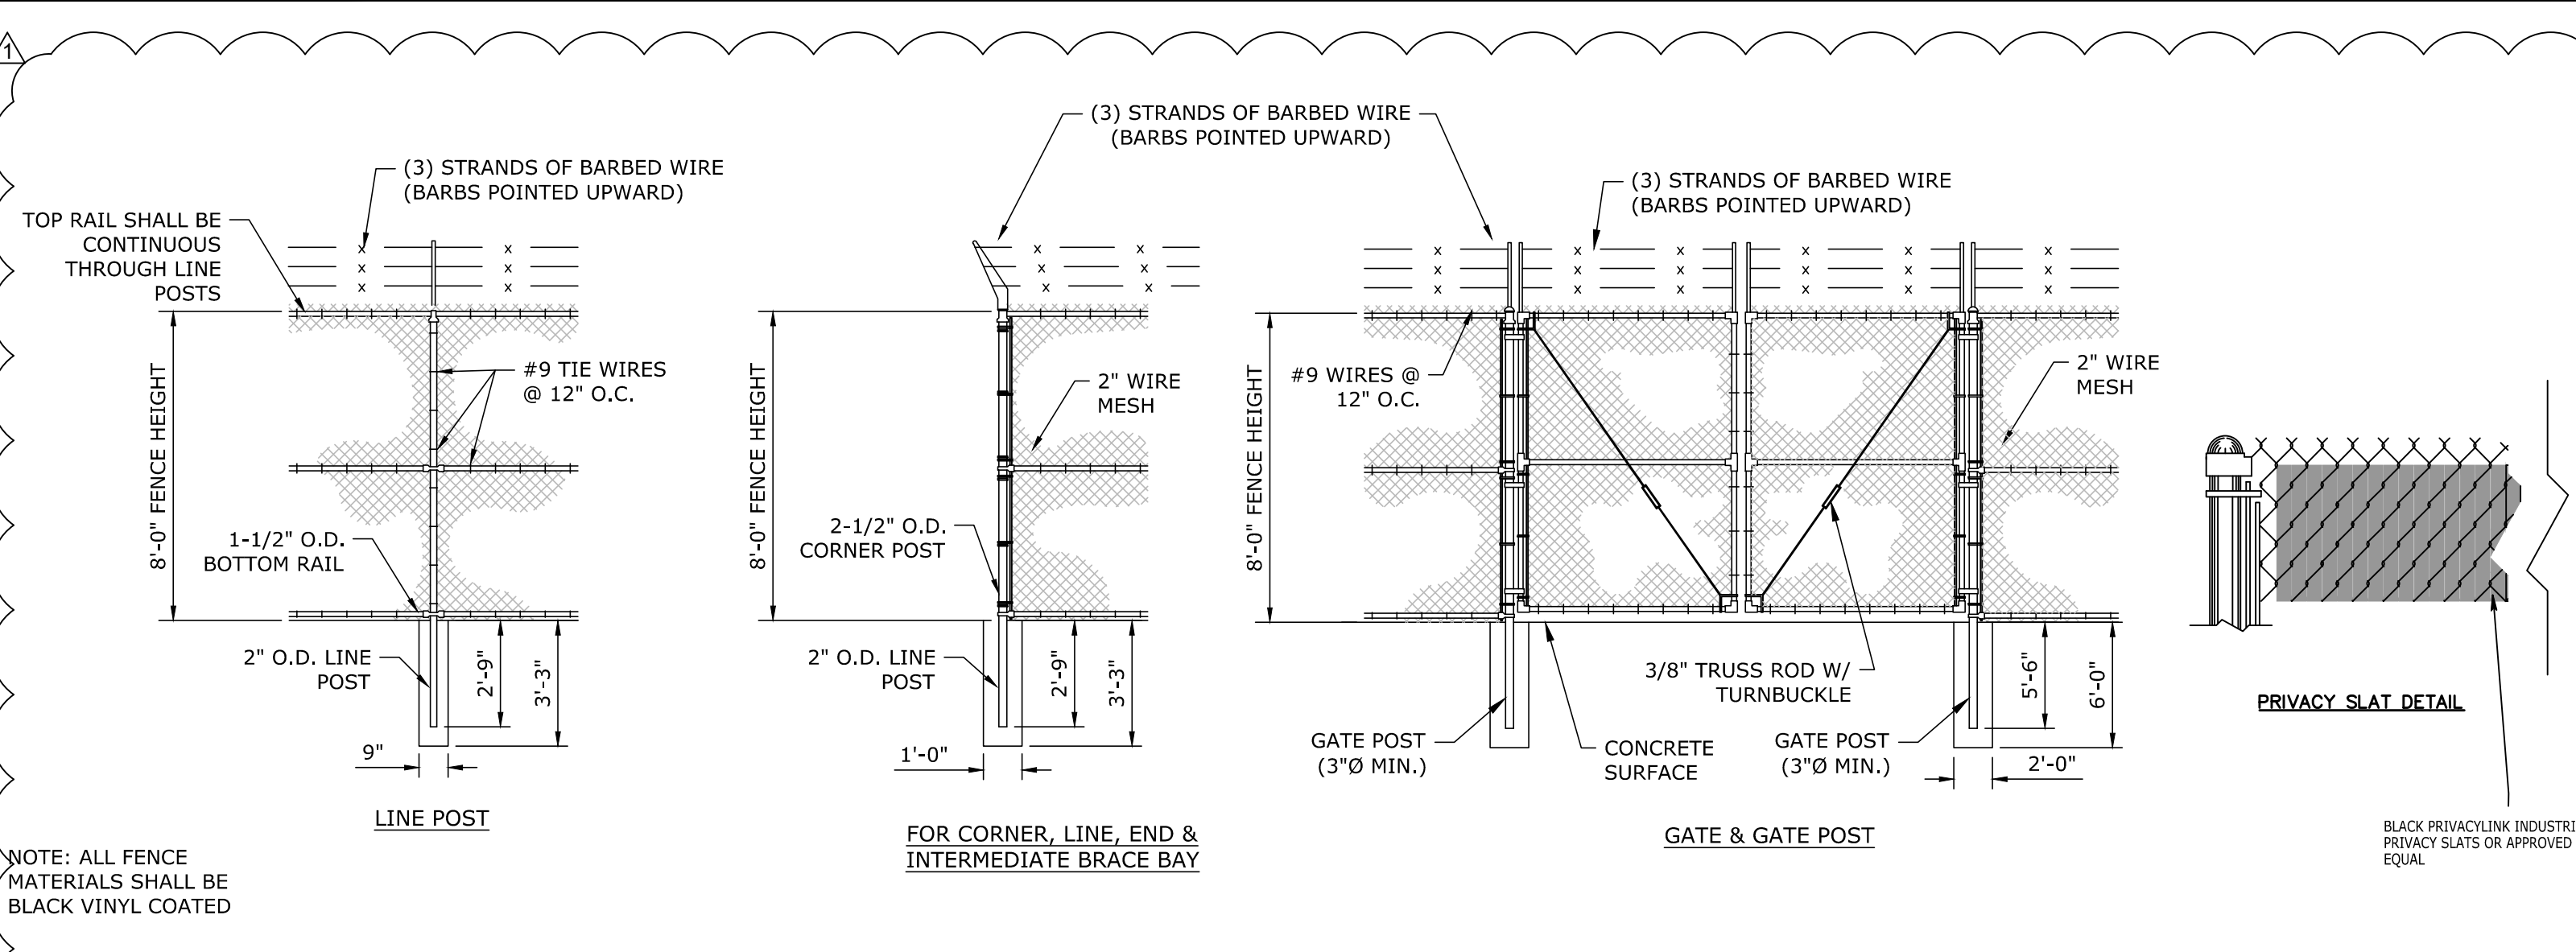


1 CHAIN LINK FENCE DETAILS NOT TO SCALE

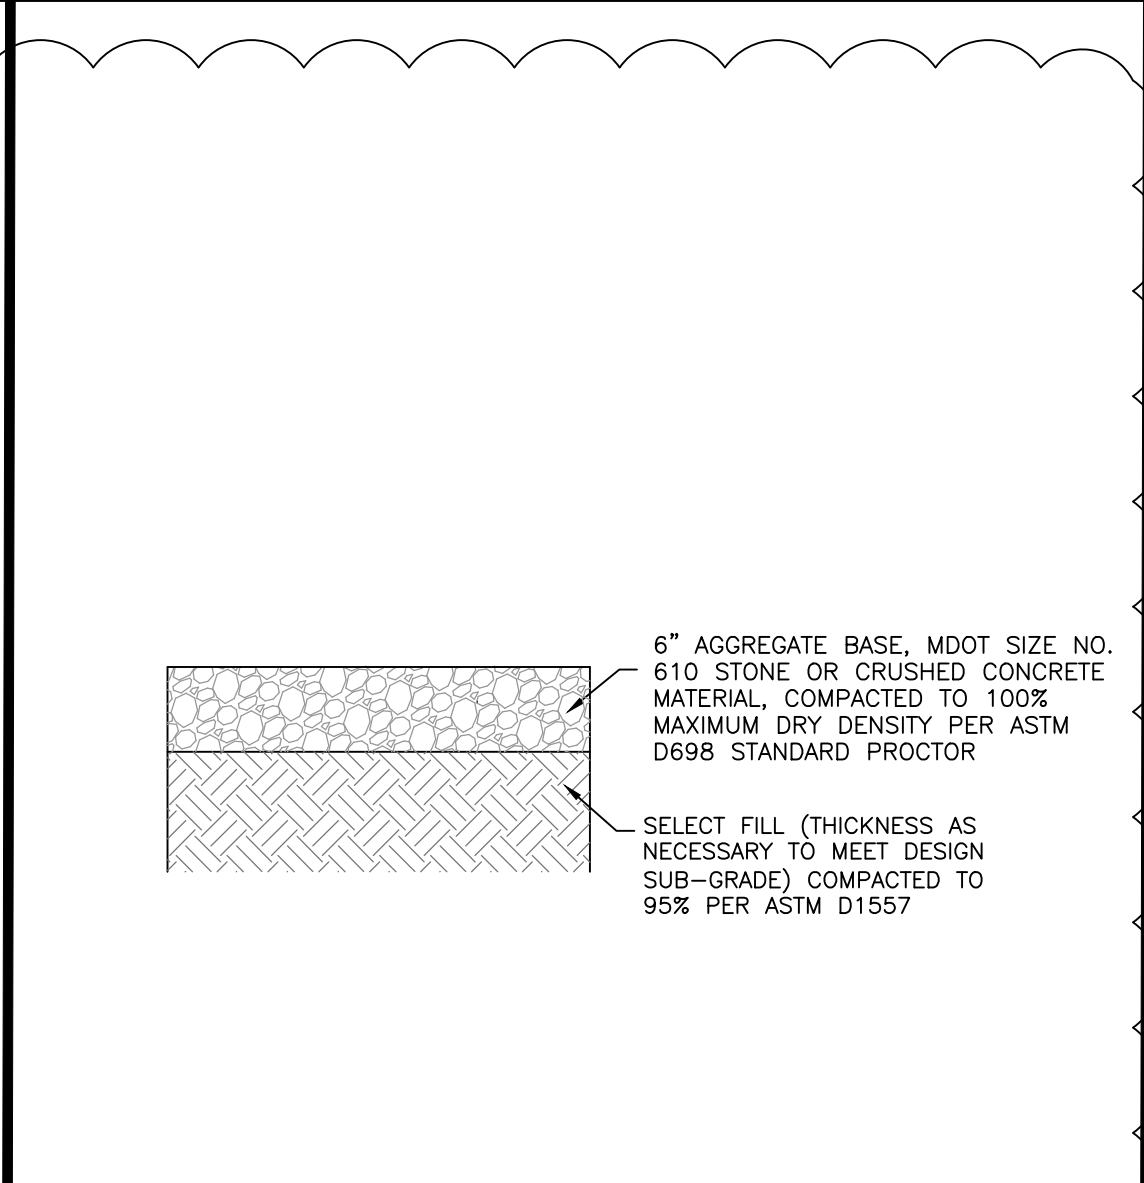

2 GRAVEL SECTION DETAIL NOT TO SCALE

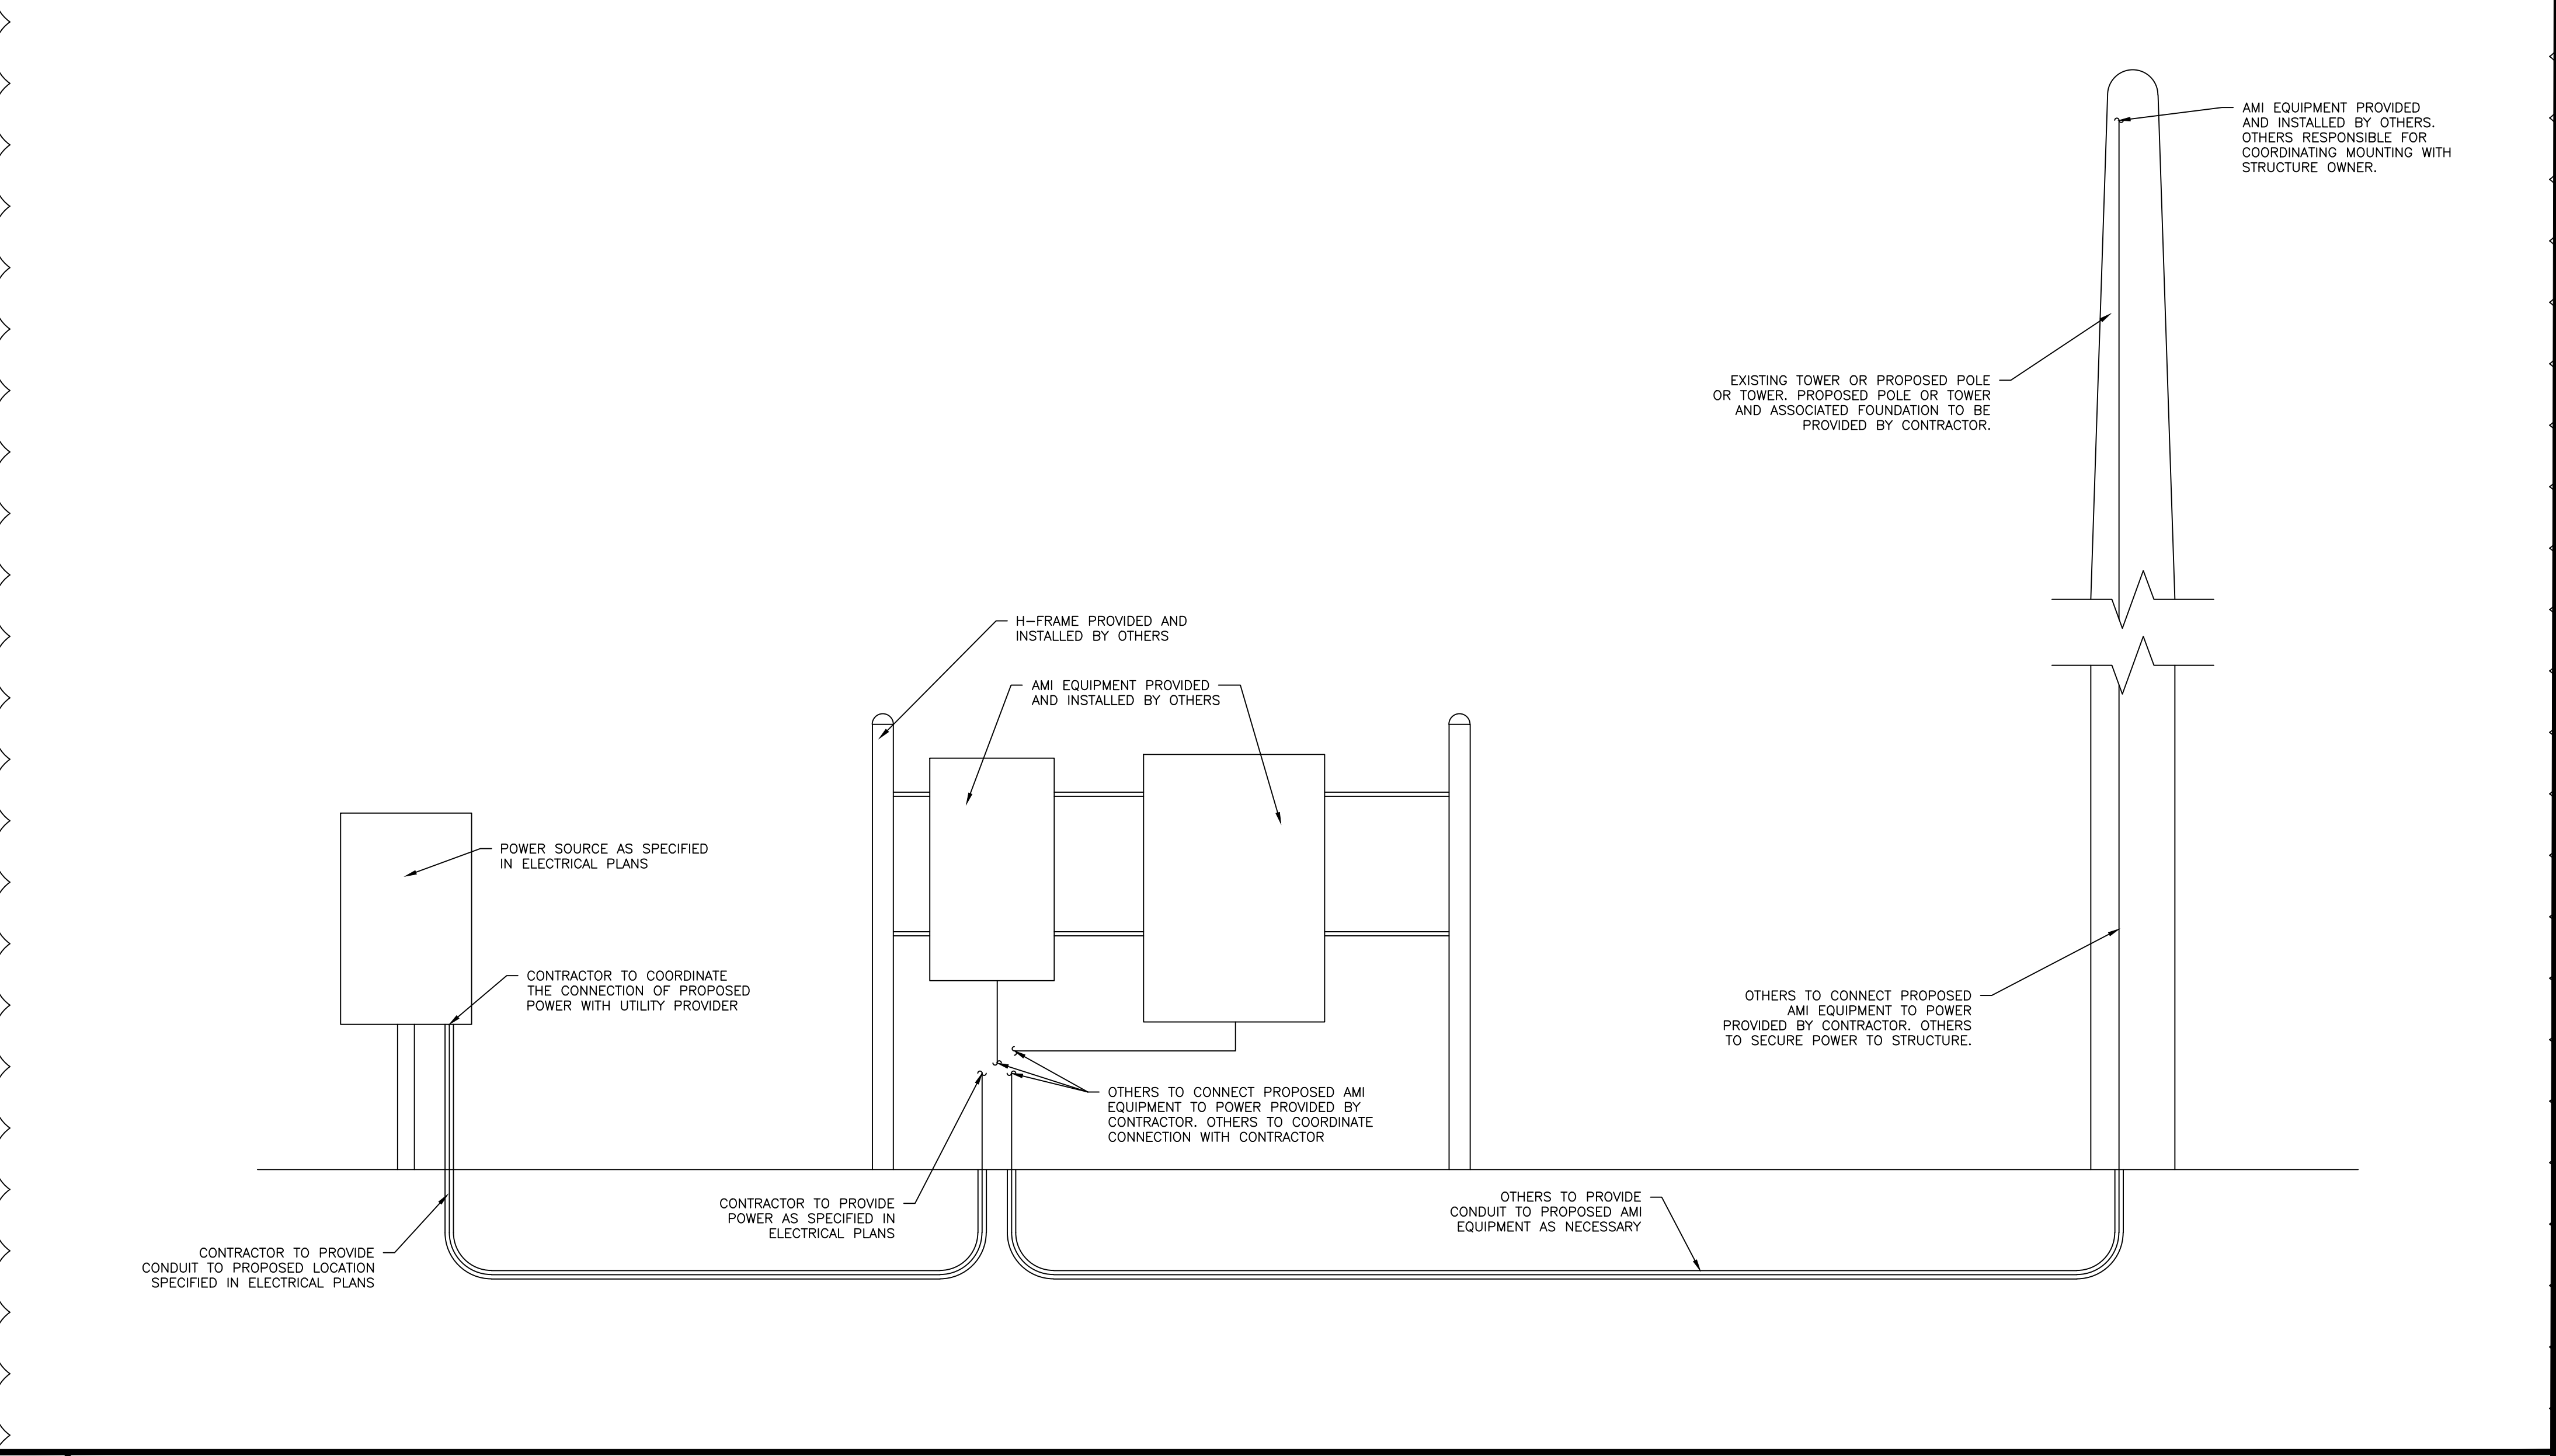

3 PROJECT SCHEMATIC NOT TO SCALE

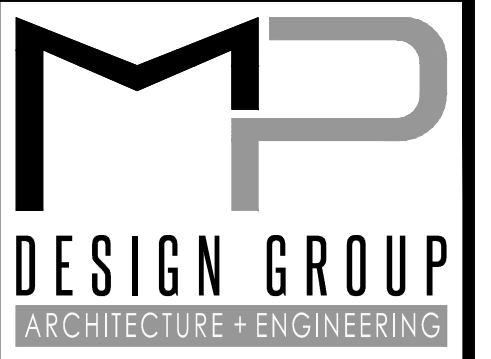

"Designed to Build"
 918 Howard Ave Suite F
 Biloxi, Mississippi 39530
 P: 228.388.1950
 www.mpdesigngroup.us

David J. Machado, PE
 Brad P. Patano, PE
 Gerrad W. Kilpatrick, PE
 Bradford A. Jones, AIA
 Fernanda A. Silva, AIA



**CONSTRUCTION PLANS FOR
 AMI SYSTEM IMPROVEMENTS
 WEST JACKSON COUNTY
 UTILITY DISTRICT**

7200 MCCANN ROAD, BILOXI, MS 39532

SCALE: AS INDICATED
 PROJECT NO: 0225.21.004
 DRAWN BY: JGP
 CHECKED BY: GWK

CIVIL SITE DETAILS

NO.	DATE	REVISION / SUBMITTAL
REV 0	10.14.22	ISSUED FOR CONSTRUCTION
REV 1	11.16.22	ADDENDUM 001

C620

VERIFY SCALES
 BAR IS ONE INCH ON ORIGINAL DRAWING
 IF NOT ONE INCH ON THIS SHEET, ADJUST SCALES ACCORDINGLY

THE ORIGINAL, SIGNED, DATED AND SEALED ENGINEERING PLANS ARE THE OFFICIAL DOCUMENTS SUBMITTED TO THE APPROVING AUTHORITY FOR THESE PLANS. CONTRACTOR / SUBCONTRACTOR / AND/OR OWNER SHALL CONSULT ENGINEERED PLANS TO VERIFY ANY CONDITIONS OR RESTRICTIONS THAT MAY HAVE BEEN REQUIRED BY THE APPROVING AUTHORITY OR APPROVED BY THE REGISTERED ENGINEER OF RECORD. IF DISCREPANCIES OCCUR, THE ORIGINAL, SIGNED, DATED AND SEALED ENGINEERING PLAN SET SHALL OVERRIDE ANY OTHER PLANS. THE DRAWINGS, DETAILS, AND NOTES THAT APPEAR ON THIS SHEET ARE COPYRIGHTED BY MACHADO | PATANO, P.L.L.C. AND CLAIM ALL RIGHTS OF THE COPYRIGHT LAWS. © COPYRIGHTED MATERIAL