

ADDENDUM 1 ELEVATED REEFER PLUGS

Date: May 12, 2023

Project #: 0297.22.002

Project Name: Elevated Reefer Plugs
30th Avenue
Gulfport, MS 39501

Owner: Mississippi State Port Authority Port of Gulfport
30th Avenue
Gulfport, MS 39501

To: All Prospective Bidders

From: Nick Moody, PE, LEED AP BD+C

Bidders are hereby informed that the Project Manual and Drawings are modified as follows:

This Addendum forms a part of the Contract Documents and modifies the original Bidding Documents with a submittal signed and stamped date of April 13, 2023. It is the General Contractor's responsibility for providing proper acknowledgement and receipt of this Addendum in the Bid Forms/Document.

Attachments to this Addendum: As described herein

Total Number of Pages in this Addendum: 16 Pages

PART A: GENERAL ADDENDUM, BIDDING, AND/OR PROJECT NOTES:

- A1. See attached for the Pre-bid Meeting Agenda.
- A2. Deliveries to the site can be escorted by personnel that has a TWIC card.
- A3. Work will be required to take place between the hours of 6:00 – 5:30. Contractor can request to work on the weekend if needed. Request must be made to the engineer-of-record and MSPA seven (7) calendar days prior to weekend being requested.

PART B: CONTRACTOR QUESTIONS WITH RESPONSES (Responses are in RED)

Note: If you do not see your question answered, then we are still researching or working on a solution.

- B1. Picture on drawing C202 shows 10.5" cores for stand posts; C620 says 8" cores for posts. Which diameter is to be drilled? Is there a known depth of the asphalt
Response: The 10.5" shown in the picture on Sheet C202 is the asphalt depth, not the core diameter. The 8" shown on C620 is the core diameter.
- B2. Is the raised structure to be built with galvanized steel and cold galvanized applied or is it to be building with carbon steel and galvanized dipped?
Response: The raised steel structure is to be hot-formed structural tubing that is blasted, primed, painted. See attached spec section 055000 Metal Fabrications.
- B3. Will stored materials/advancement of materials be paid?

Addendum 1
0297.22.002 ELEVATED REEFER PLUGS

Response: Yes, the contractor will be required to submit the following backup information for stored materials; copies of invoices clearly indicating the cost of goods and project name, insurance certificates for the facility where materials are being stored, and pictures of stored materials with labels showing the project name.

B4. Will secured laydown space be made available for this project?

Response: Yes, see attached Sheet C201 for location.

B5. Will the "UL Listed expanding foam" be supplied by the owner for the sealing of the new reefer boxes? If not, can you please provide a spec for the expanding foam?

Response: Contractor shall provide and install, match existing.

B6. Do the 2 gang reefer boxes need 3/0 XHHW-2 since they are only 60 amps?

Response: Yes

B7. Who will be responsible for the identification tags and arc flash hazard stickers located on the new reefer boxes?

Response: Provided and installed by contractor, match existing.

B8. Can consideration be made to the below statement in the contract documents (Section 3 of the General Conditions)? This puts full responsibility on the contractor in the event MSPA does not receive state/federal funding for this project.

Response: This provision does not mean that the MSPA can decide to stop a project and terminate the contract in 10 days. It is not discretionary – the MSPA would have to be out of money and the State Legislature would have to significantly cut the MSPA's budget in the next legislative session to trigger this provision.

The proposer can rest assured that sufficient funds have been budgeted and approved by the state legislature for this project. For context, this provision is designed to protect the MSPA in very large infrastructure projects, spanning multiple years and multiple budget cycles.

PART C: DRAWING CLARIFICATIONS, REVISIONS, AND ADDITIONS:

C1. See attached for the following revised drawings:

1. C201 North Harbor Site Plan
2. C620 Civil Site Details
3. E002 Electrical Abbreviations & Schedules
4. E601 Electrical One-line Diagram
5. E602 Electrical One-line Diagram
6. E603 Electrical One-line Diagram
7. E604 Electrical One-line Diagram
8. E605 Electrical One-line Diagram

PART D: SPECIFICATION CLARIFICATIONS, REVISIONS, AND ADDITIONS

D1. Information for Bidders

- Page 2 – paragraph should read: **"If Bidder does not have a Certificate of Responsibility number he can only bid on public projects seventy-five thousand dollars (\$75,000.00) or less and must provide a statement on the outside or exterior of the envelope or container containing his bid to the effect that the bid enclosed therewith does not exceed seventy-five thousand dollars (\$75,000.00)."**

D2. Omit Section 051200 – Structural Steel Framing

D3. Omit Section 099113 – Exterior Painting

D4. See attached for the following revised specifications:

1. Section 055000 – Metal Fabrications

Addendum 1

0297.22.002 ELEVATED REEFER PLUGS

PART E: APPROVED PRODUCT/VENDOR EQUALS

E1. None this addendum.

END OF ADDENDUM 1

PRE-BID MEETING

Mississippi State Port Authority at Gulfport Elevated Reefer Plugs 0297.22.002

Date/ Time:

Wednesday, May 10, 2023

Pre-Bid Meeting Location:

Mississippi State Port Authority at Gulfport (MSPA)
2510 14th Street
Gulfport, MS 39501

Introductions:

- Owner Representatives:
 - James Buras, PE – Port Engineer
 - Teresa Ehrlich – Project Manager
 - Cindy Ford – Engineering Administrative Assistant
- Design Team:
 - David Machado, PE – Principal-in-charge
 - Nick Moody, PE, LEED AP BD+C – Project Manager
 - Kenny Beverin – Project Engineer

Project Location:

Mississippi State Port Authority at Gulfport
North Harbor

Project Description

- This project consists of the demolition and replacement of the existing reefer plugs located north of the west pier in the Port of Gulfport. The new reefer plugs will be elevated on fabricated pedestals to an elevation of 4 ft. above existing grade.

Bid Day:

- Thursday, May 25, 2023
- Sealed Bids inside an opaque envelope are due by 2:00 PM. Late bids will be considered invalid.
- Bids shall be delivered to 2510 14th Street, Suite 1450, Gulfport, Mississippi, 39501
- Bid Opening: Same day, after the bids are due bids will be opened, read out loud, and recorded.
- Review page 2 of the Advertisement to Bid along with the General Conditions for information required to submit with your bid.
- Use the MSPA bid form provided in the Project Manual. Be sure to complete, sign, and date the form.
- Complete the Certification Regarding Debarment Form included in the Project Manual.
- Complete the List of Subcontractors.
- Review insurance requirements/provisions for labor laws.
- Certification Letter stating the bidder will agree to use Mississippi products over non-Mississippi products when all things are equal with respect to price, quality, availability and service.
- Certification Letter stating all new labor hires will be residents of Mississippi.
- Non-resident Bidder – must provide a copy of contractor's current State law pertaining to own State's treatment of non-resident contractors.
- Provide two (2) copies of all submission documents.
- Bid must be accompanied by cash, a cashier's check, certified check or bid bond in the amount of ten percent (10%) of the total bid amount.

- Mark the outside of the envelope clearly with the following information:
 - Project Name
 - Bid Date
 - Company Name
 - Company Address
 - All applicable state license and certificate numbers
 - Certificate of Responsibility Number is required for bids over \$50,000
 - No modifications may be made to the bid on the outside of the envelope.

Information for Bidders:

- All questions must be submitted electronically via email to Cindy Ford at cford@shipmspa.com.
- All addenda will be issued electronically via email from MSPA and from Central Bidding
- Cut off for questions will be Wednesday, May 17th at 5:00 pm.
- Contractor will be required to execute the Contract within fourteen (14) calendar days from the date of Notice of Award.
- After approval by the MSPA Board at its monthly meeting the contract will then be sent to MDA for execution. A fully executed contract should be distributed within 30 days of MDA's signature.

Addenda:

- None at this time.
- Addendum 01 coming this week

Alternates:

- No alternates

Time of Completion:

- Contract Time: 240 days.
- Inclement Weather Days will be allowed. Contractor is required to provide written notification of request within 10 days of the inclement weather event.

Liquidated Damages:

- \$500.00 for each calendar day over the contract time.

Submittals:

- Procore Software shall be the basis for file sharing, submittal review, and all other transmittals pertaining to the Work.

Work Constraints:

- TWIC cards will be required for all personnel.
- Company vehicles used to access the site will have to be registered with MSPA operations.
- Owner will continue to occupy adjacent buildings and portions of the site. Confine operations to within limits of work.
- Coordinate job security with the MSPA security and operations.
- No obstruction of roadways, sidewalks, or other public pathways is allowed.
- No deadly weapons of any kind are permitted on the property.
- No tobacco products or alcohol are allowed on the construction site, or anywhere on the MSPA property
- Coordinate utility outages with Engineer of Record seven (7) days prior.
- Hurricane Season: Contractor is responsible for any additional mobilization/storage costs made necessary by a hurricane threat level issued by the National Hurricane Center/NOAA/NWS

Temporary Facilities and Controls:

- Temporary restrooms will be required.
- Job Security will be by the GC per contract.
- Waste removal is required to maintain a clean and orderly site
- No burning or burying of waste allowed on site
- Securing active work zones and providing barriers any unauthorized peoples will be the responsibility of the GC through the duration of the project.
-

Temporary Utilities:

- Temporary utilities, i.e., wifi/internet, water, sewer, electrical, etc. will be at the contractor's expense.

Parking and Laydown:


- Certain existing parking areas can be used by the construction personnel. This will be coordinated with the Owner after contract award along with a designated area for laydown.

Specific Project Information:


- New reefer plugs will be provided by the owner. MSPA staff will have a transfer sheet to keep track of reefer plugs that are provided to the contractor. New reefer plugs will be released to the contractor by MSPA at the start of each milestone.
- Existing reefer plugs will be supplied to the owner once removed. MSPA staff will also have a transfer sheet to keep track of existing plugs provided to the owner. Existing reefer plugs will be accepted by MSPA at the completion of each milestone is verified.
- Project Milestones (7 Total):
 - Milestones #1 – 7
 - Existing reefer plugs to be disconnected and removed. Plugs and plug covers should be provided to the owner. Contractor to coordinate delivery with the owner.
 - Install new reefer plug supports.
 - Install reefer plugs and reconnect to existing electrical conductor.
 - Test each reefer plug to ensure they're operational.
 - Once all work has been approved by the engineer-of-record and the owner, then the contractor can proceed to the next milestone.

Questions

PRINTED: 5/12/2023 2:17 PM BY: Nick Moody LAST SAVED: 5/12/2023 2:09 PM BY: Nimood
 m:\0297_mspa_gulfport\0297.22.003_work order no 2 - reefer plug replacement & mitigation\02--civil\03--production\03--production drawings\reefer plugs site.dwg

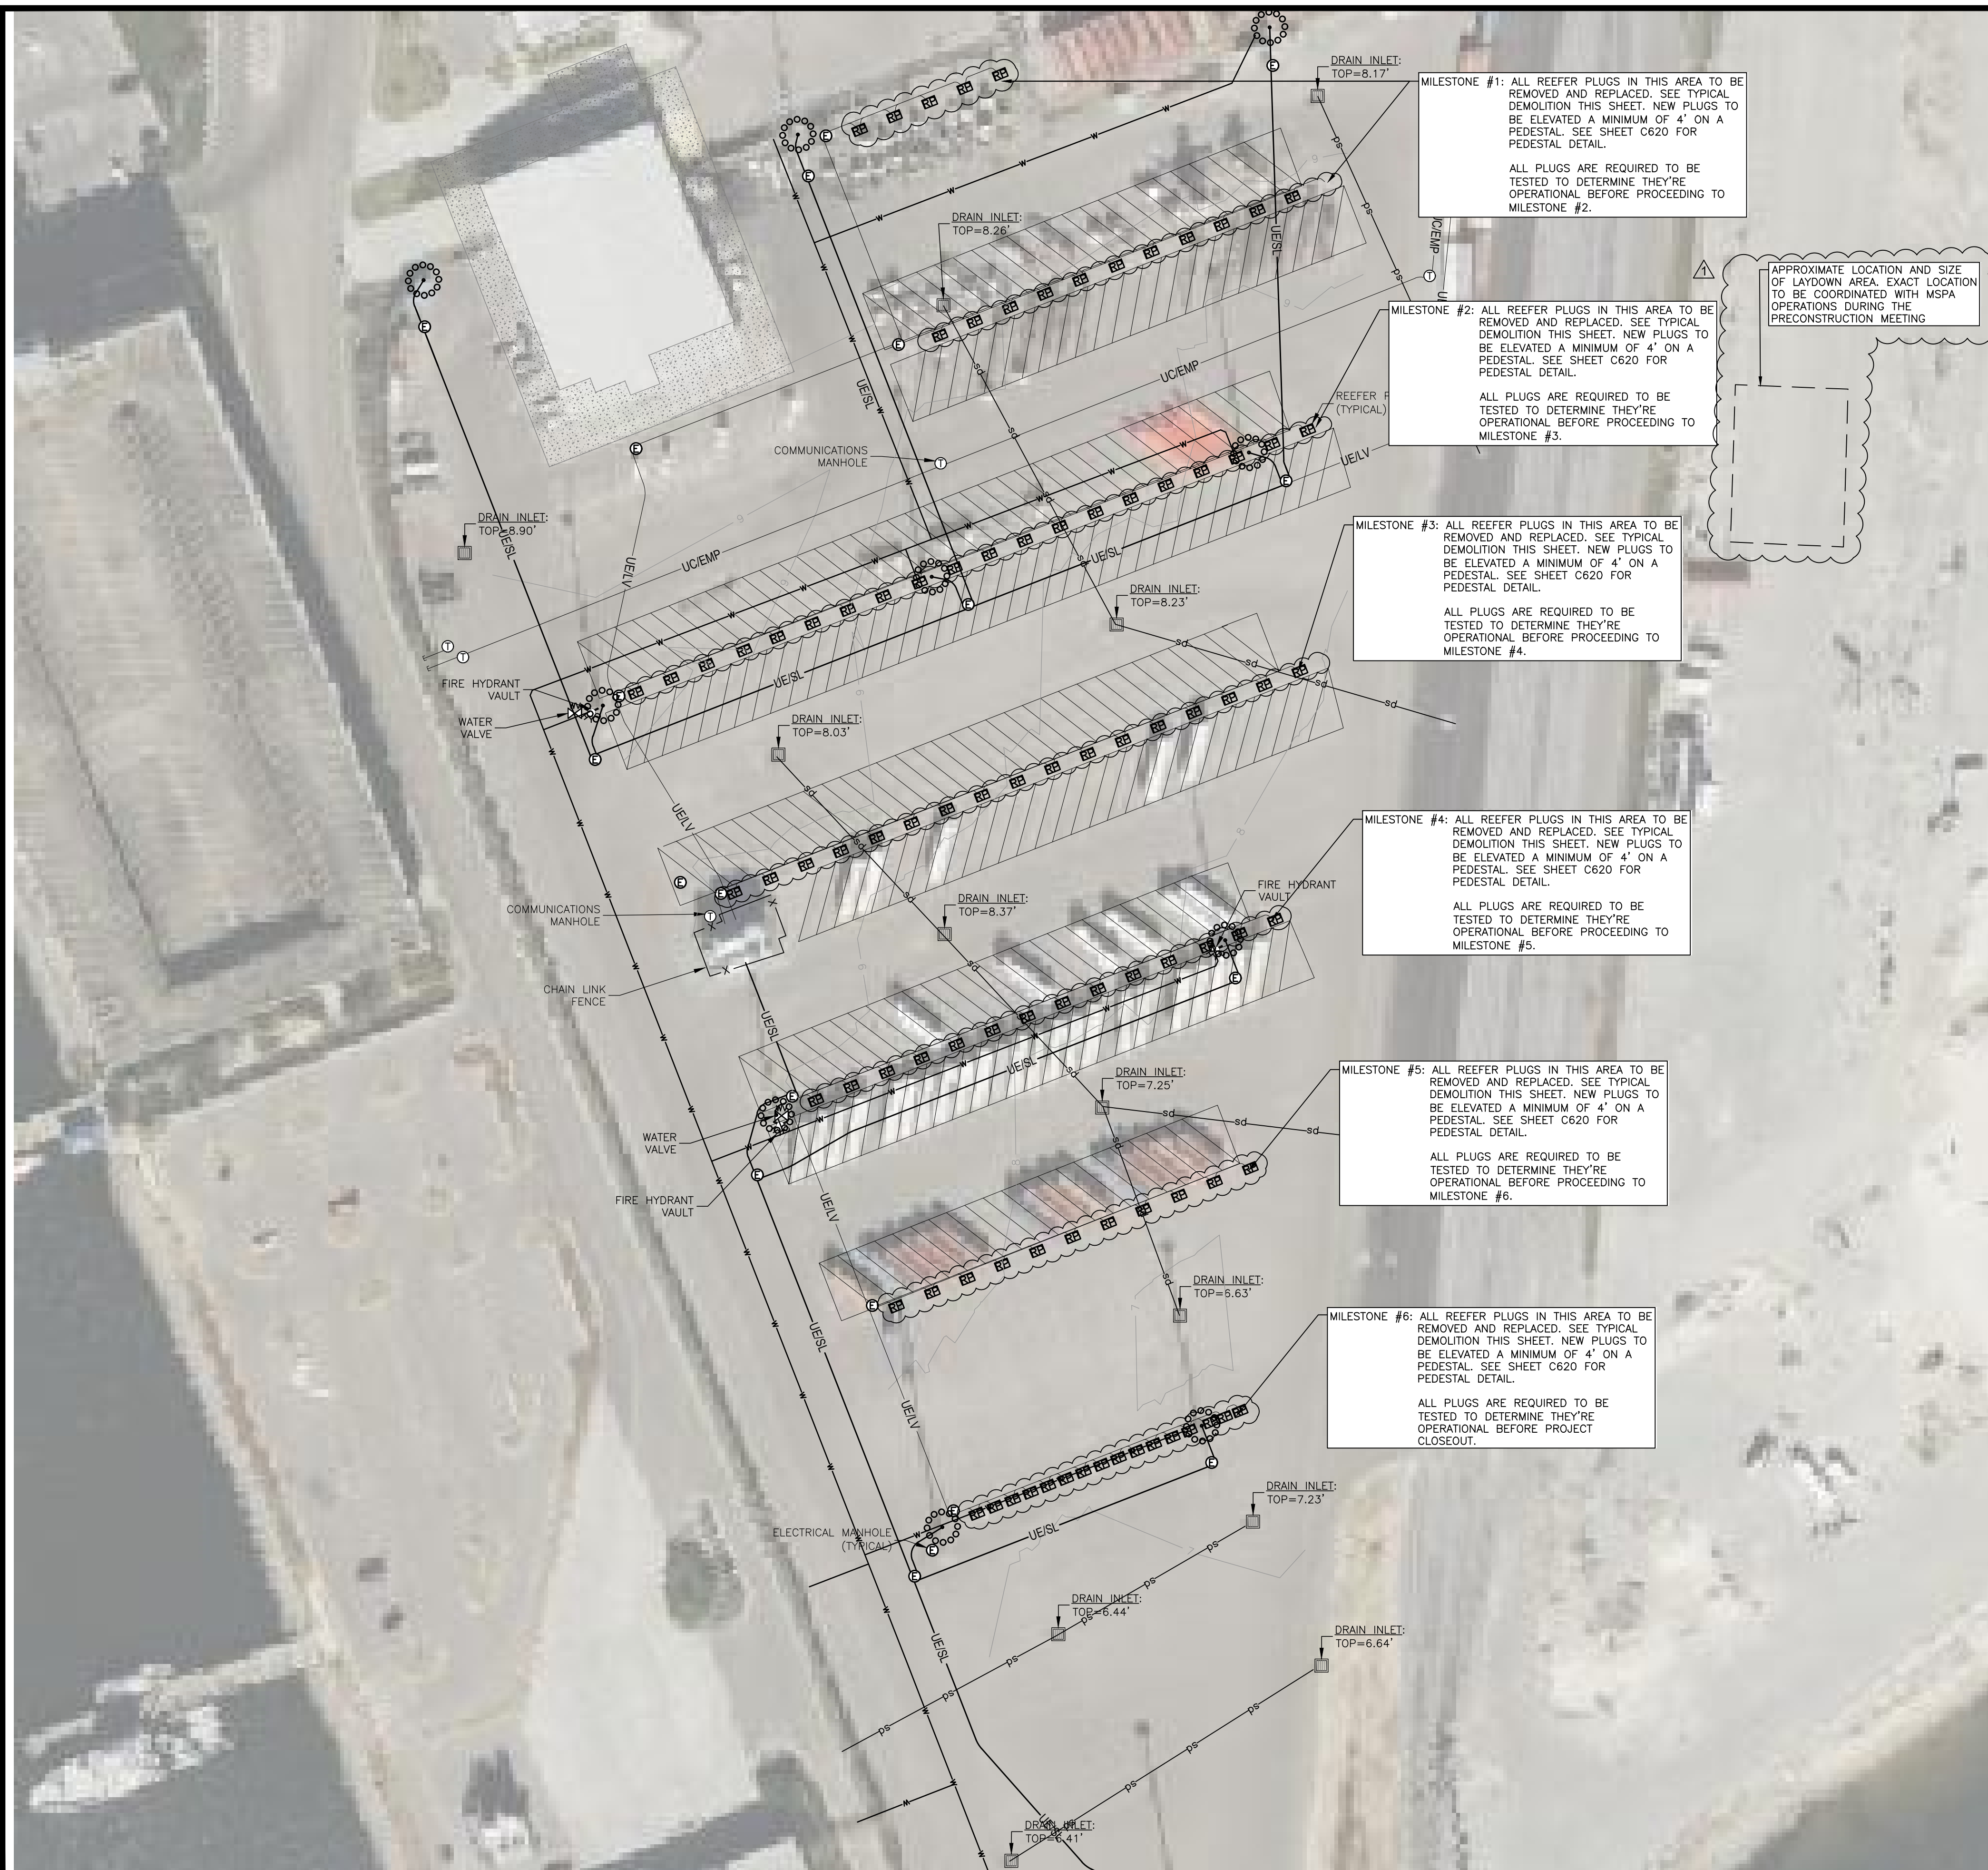

SURVEY LEGEND	
	DENOTES WATER VALVE
	DENOTES ELECTRICAL MANHOLE
	DENOTES FIRE HYDRANT
	DENOTES DRAIN INLET
	DENOTES COMMUNICATIONS MANHOLE
	DENOTES REEFER PLUG

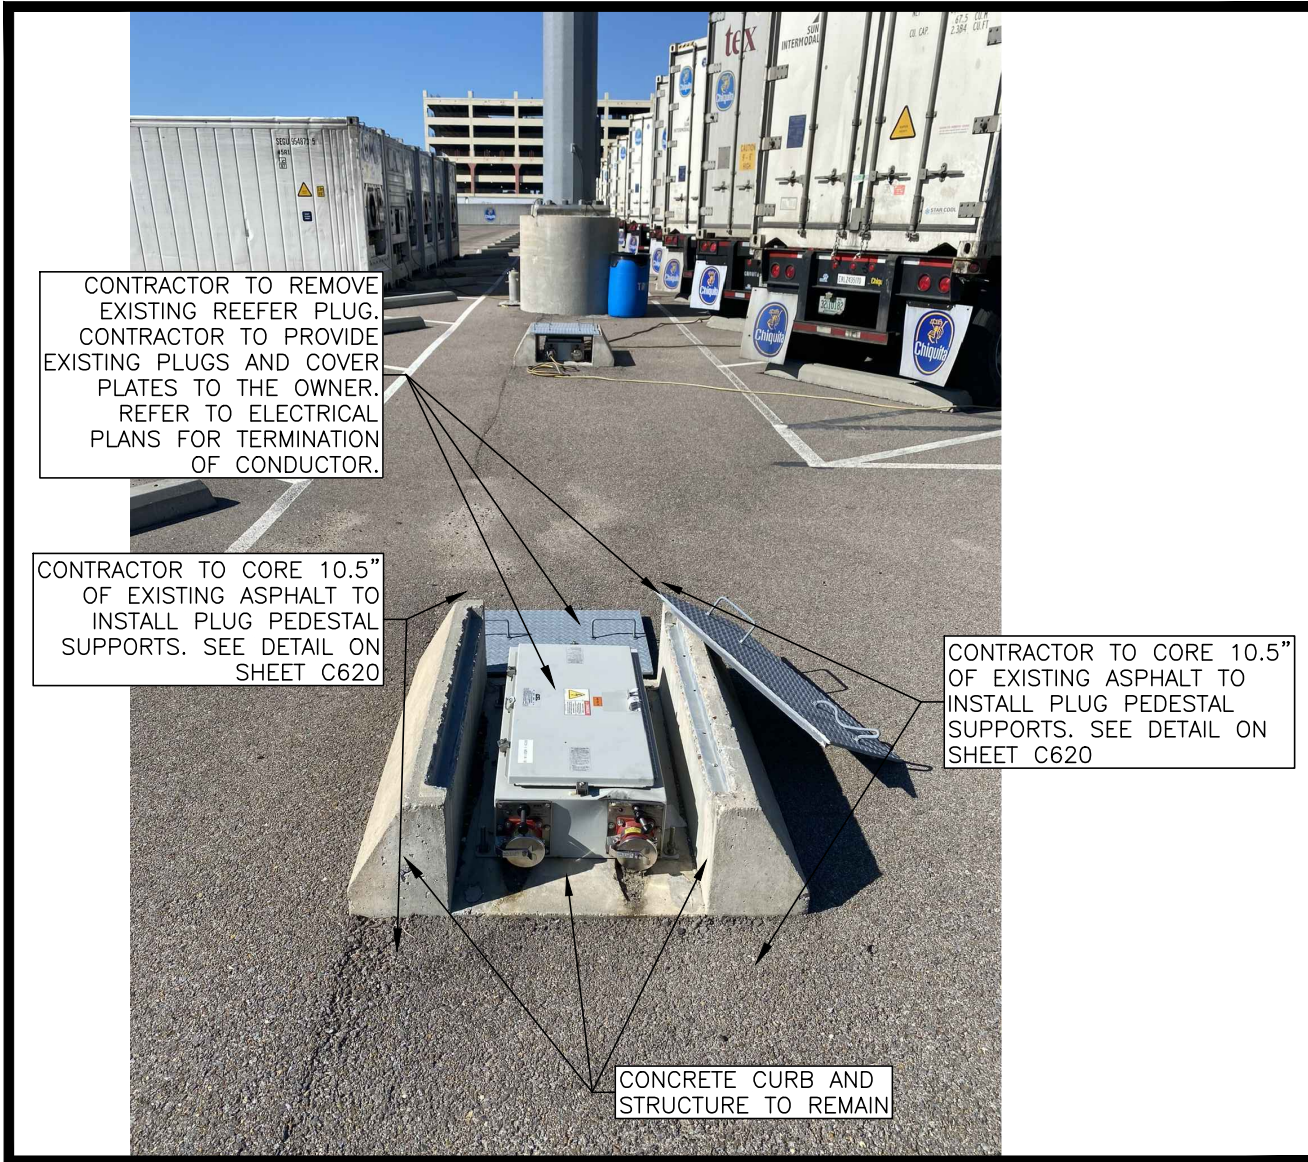

TYPICAL EXISTING REEFER PLUG DEMOLITION

MILESTONE #1: ALL REEFER PLUGS IN THIS AREA TO BE REMOVED AND REPLACED. SEE TYPICAL DEMOLITION THIS SHEET. NEW PLUGS TO BE ELEVATED A MINIMUM OF 4' ON A PEDESTAL. SEE SHEET C620 FOR PEDESTAL DETAIL.
 ALL PLUGS ARE REQUIRED TO BE TESTED TO DETERMINE THEY'RE OPERATIONAL BEFORE PROCEEDING TO MILESTONE #2.

MILESTONE #2: ALL REEFER PLUGS IN THIS AREA TO BE REMOVED AND REPLACED. SEE TYPICAL DEMOLITION THIS SHEET. NEW PLUGS TO BE ELEVATED A MINIMUM OF 4' ON A PEDESTAL. SEE SHEET C620 FOR PEDESTAL DETAIL.
 ALL PLUGS ARE REQUIRED TO BE TESTED TO DETERMINE THEY'RE OPERATIONAL BEFORE PROCEEDING TO MILESTONE #3.



MILESTONE #3: ALL REEFER PLUGS IN THIS AREA TO BE REMOVED AND REPLACED. SEE TYPICAL DEMOLITION THIS SHEET. NEW PLUGS TO BE ELEVATED A MINIMUM OF 4' ON A PEDESTAL. SEE SHEET C620 FOR PEDESTAL DETAIL.
 ALL PLUGS ARE REQUIRED TO BE TESTED TO DETERMINE THEY'RE OPERATIONAL BEFORE PROCEEDING TO MILESTONE #4.

MILESTONE #4: ALL REEFER PLUGS IN THIS AREA TO BE REMOVED AND REPLACED. SEE TYPICAL DEMOLITION THIS SHEET. NEW PLUGS TO BE ELEVATED A MINIMUM OF 4' ON A PEDESTAL. SEE SHEET C620 FOR PEDESTAL DETAIL.
 ALL PLUGS ARE REQUIRED TO BE TESTED TO DETERMINE THEY'RE OPERATIONAL BEFORE PROCEEDING TO MILESTONE #5.

MILESTONE #5: ALL REEFER PLUGS IN THIS AREA TO BE REMOVED AND REPLACED. SEE TYPICAL DEMOLITION THIS SHEET. NEW PLUGS TO BE ELEVATED A MINIMUM OF 4' ON A PEDESTAL. SEE SHEET C620 FOR PEDESTAL DETAIL.
 ALL PLUGS ARE REQUIRED TO BE TESTED TO DETERMINE THEY'RE OPERATIONAL BEFORE PROCEEDING TO MILESTONE #6.

MILESTONE #6: ALL REEFER PLUGS IN THIS AREA TO BE REMOVED AND REPLACED. SEE TYPICAL DEMOLITION THIS SHEET. NEW PLUGS TO BE ELEVATED A MINIMUM OF 4' ON A PEDESTAL. SEE SHEET C620 FOR PEDESTAL DETAIL.
 ALL PLUGS ARE REQUIRED TO BE TESTED TO DETERMINE THEY'RE OPERATIONAL BEFORE PROJECT CLOSEOUT.

APPROXIMATE LOCATION AND SIZE OF LAYDOWN AREA. EXACT LOCATION TO BE COORDINATED WITH MSPA OPERATIONS DURING THE PRECONSTRUCTION MEETING

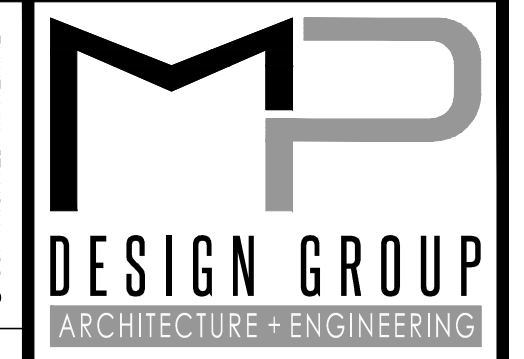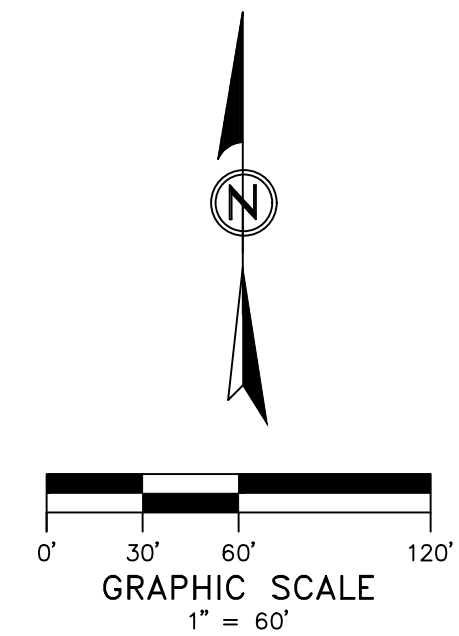

"Designed to Build"
 918 Howard Ave Suite F
 Biloxi, Mississippi 39530
 P: 228.388.1950
 www.mpdesigngroup.us

David J. Machado, PE
 Brad P. Patano, PE
 Gerrod W. Kilpatrick, PE
 Bradford A. Jones, AIA
 Fernanda A. Silva, AIA



ELEVATED REEFER PLUGS
PORT OF GULFPORT MISSISSIPPI
STATE PORT AUTHORITY
 30TH AVENUE
 GULFPORT, MS 39501

SCALE: AS INDICATED
 PROJECT NO: 0297.22.002
 DRAWN BY: NWM
 CHECKED BY: NWM

NORTH HARBOR SITE PLAN


NO.	DATE	REVISION / SUBMITTAL
REV 0	4/13/2023	ISSUED FOR CONSTRUCTION
REV 1	5/12/2023	ADDENDUM 01

C201


VERIFY SCALES
 BAR IS ONE INCH ON ORIGINAL DRAWING
 IF NOT ONE INCH ON THIS SHEET, ADJUST SCALES ACCORDINGLY

THE ORIGINAL SIGNED, DATED AND SEALED ENGINEERING PLANS ARE THE OFFICIAL DOCUMENTS SUBMITTED TO THE APPROVING AUTHORITY FOR THESE PLANS. CONTRACTOR / SUBCONTRACTOR / AND/OR OWNER SHALL CONSULT ENGINEERED PLANS TO VERIFY ANY CONDITIONS OR RESTRICTIONS THAT MAY HAVE BEEN REQUIRED BY THE APPROVING AUTHORITY OR APPROVED BY THE REGISTERED ENGINEER OF RECORD. IF DISCREPANCIES OCCUR, THE ORIGINAL SIGNED, DATED AND SEALED ENGINEERED PLAN SET SHALL OVERRIDE ANY OTHER PLANS, THE DRAWINGS, DETAILS, AND NOTES THAT APPEAR ON THIS SHEET ARE COPYRIGHTED BY MACHADO | PATANO, PLLC, AND CLAIM ALL RIGHTS OF THE COPYRIGHT LAWS. © COPYRIGHTED MATERIAL


PRINTED: 5/12/2023 2:09 PM BY: Nick Moody LAST SAVED: 5/12/2023 2:09 PM BY: Nmoody
 m:\0297_mspa_gulfport\0297.22.003_work order no 2 - reefer plug replacement & mitigation\02-civil\03-production drawings\reefer plugs site.dwg

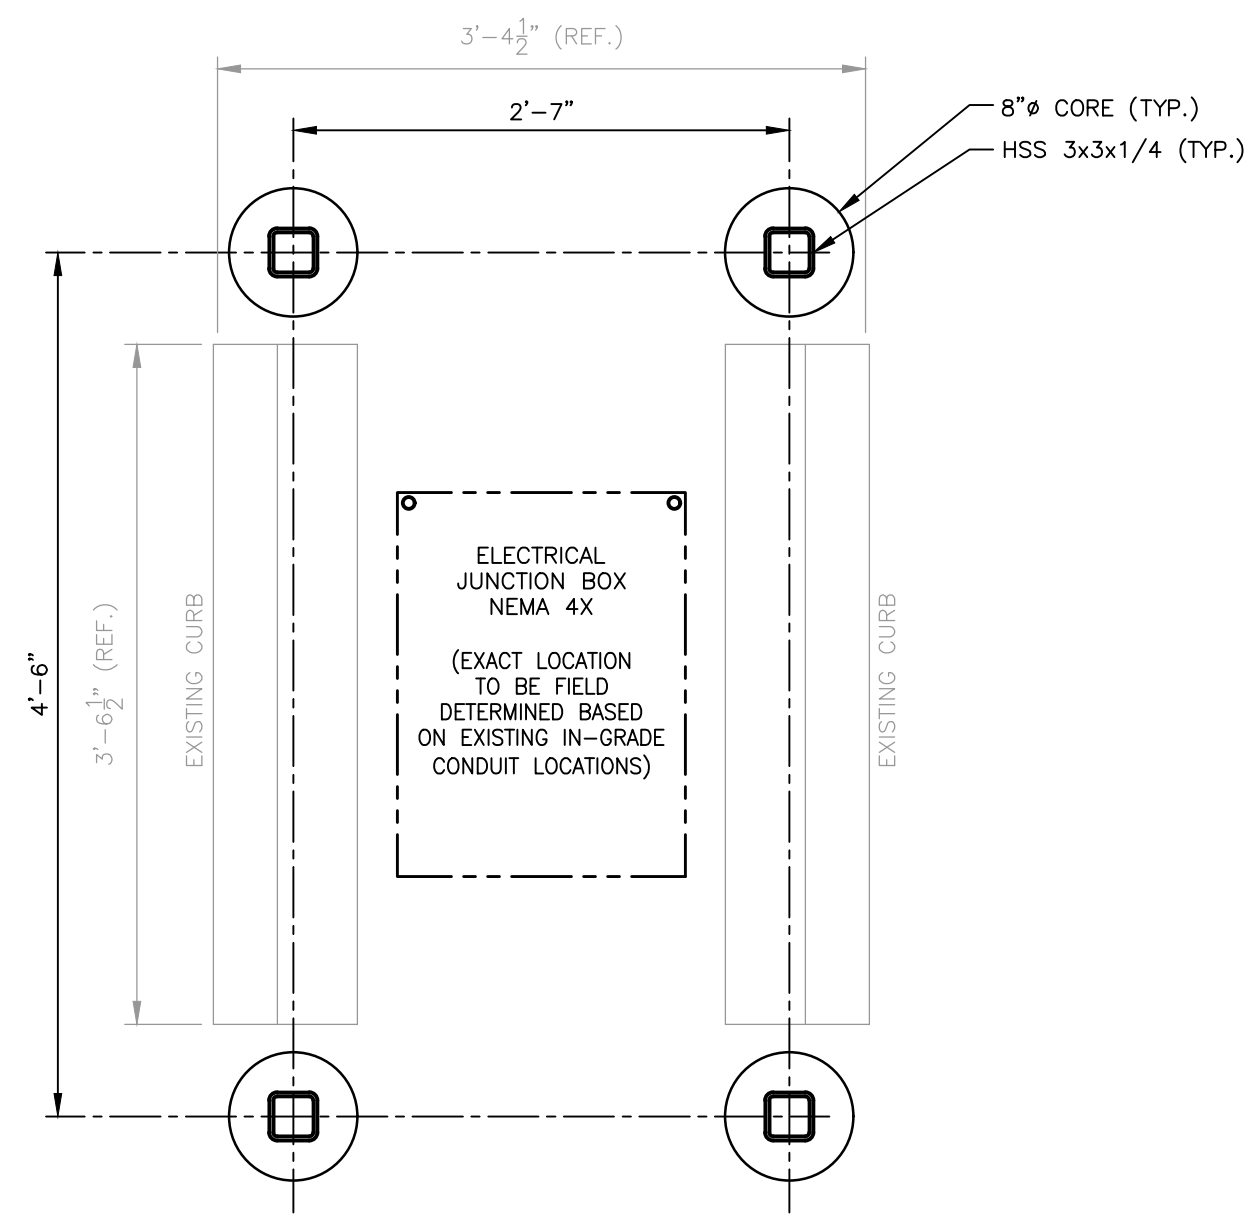


FOUNDATION PLAN

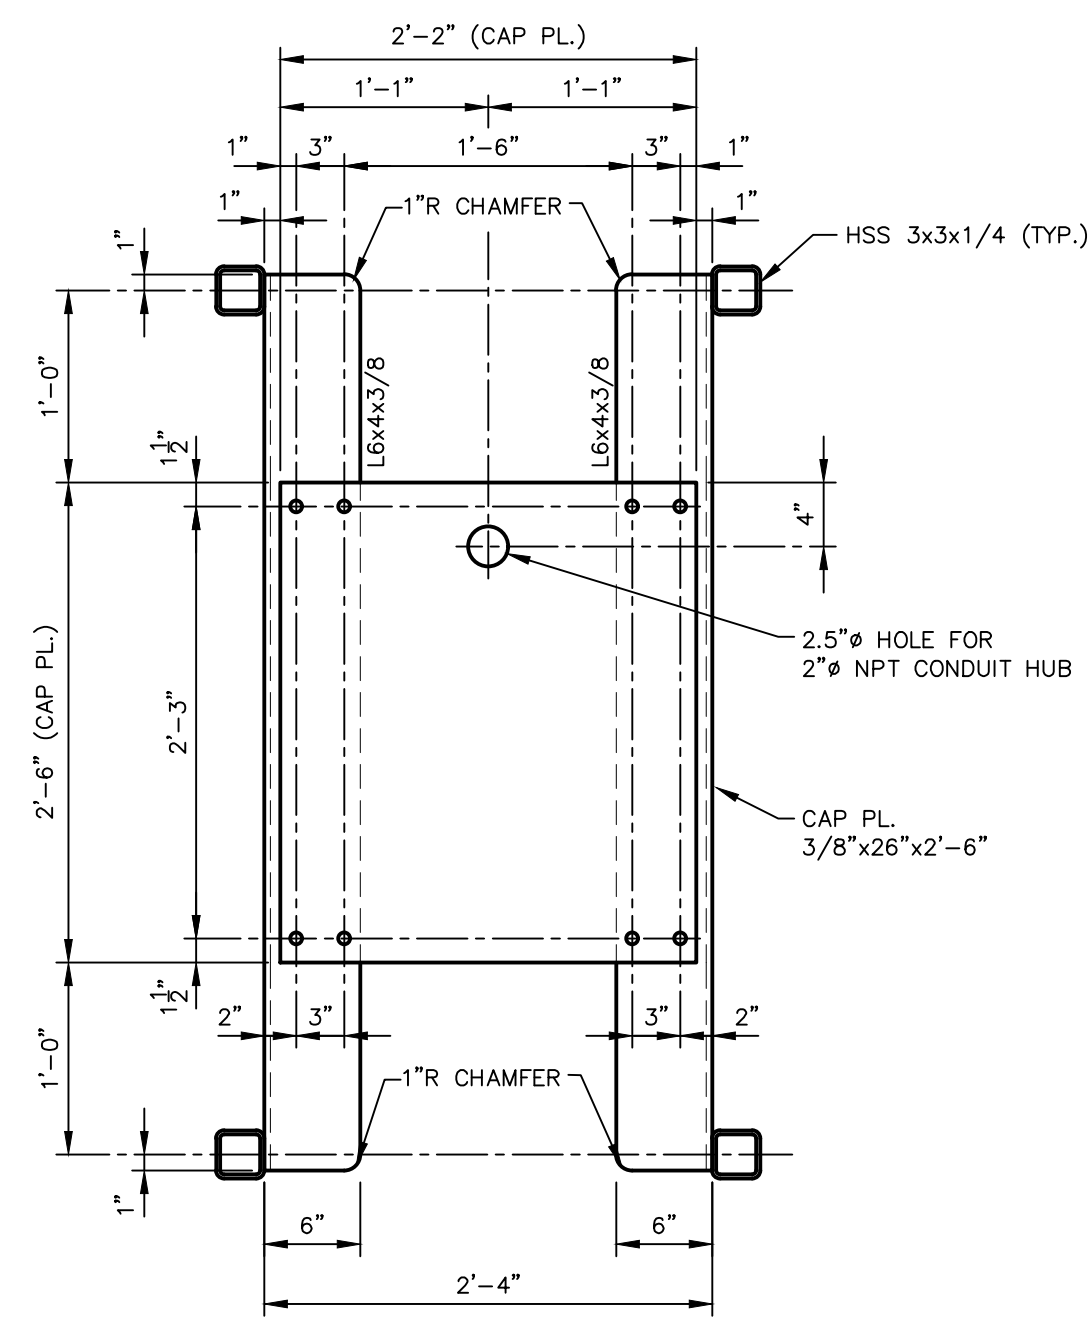

FRAMING PLAN

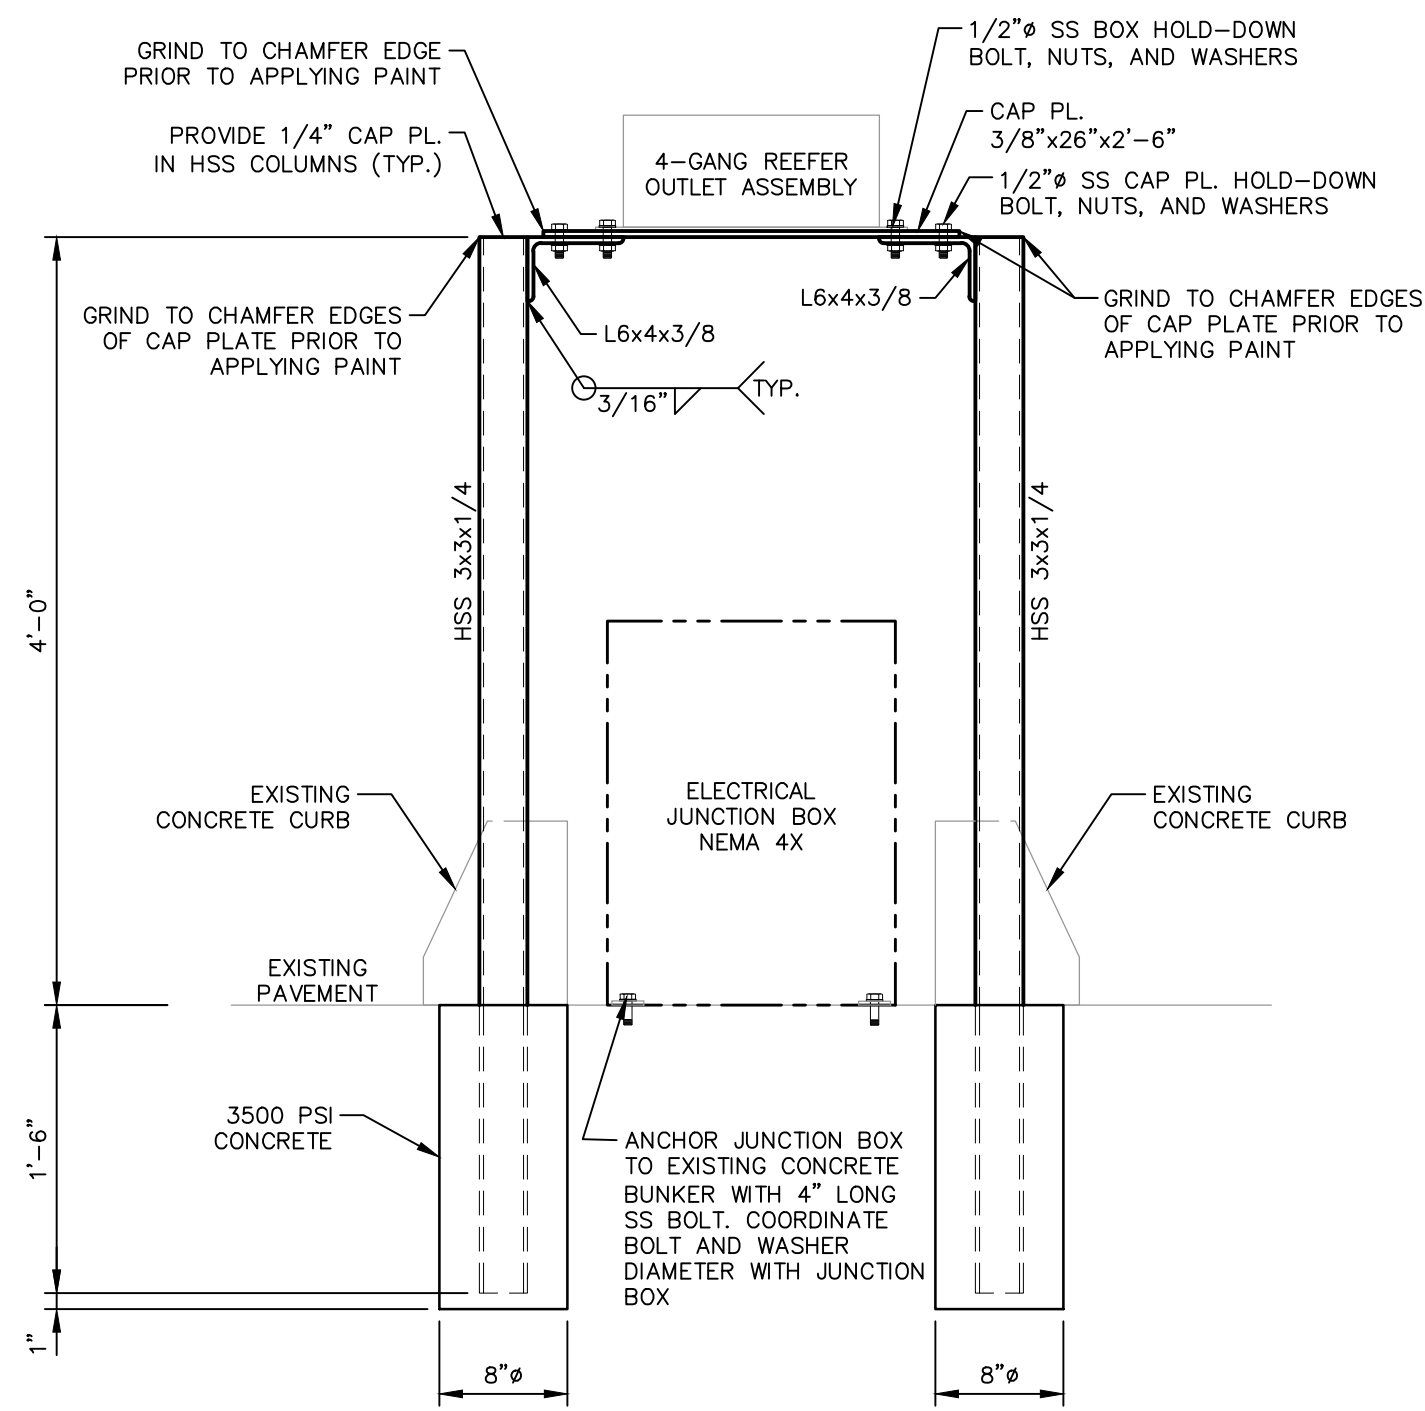

ELEVATION

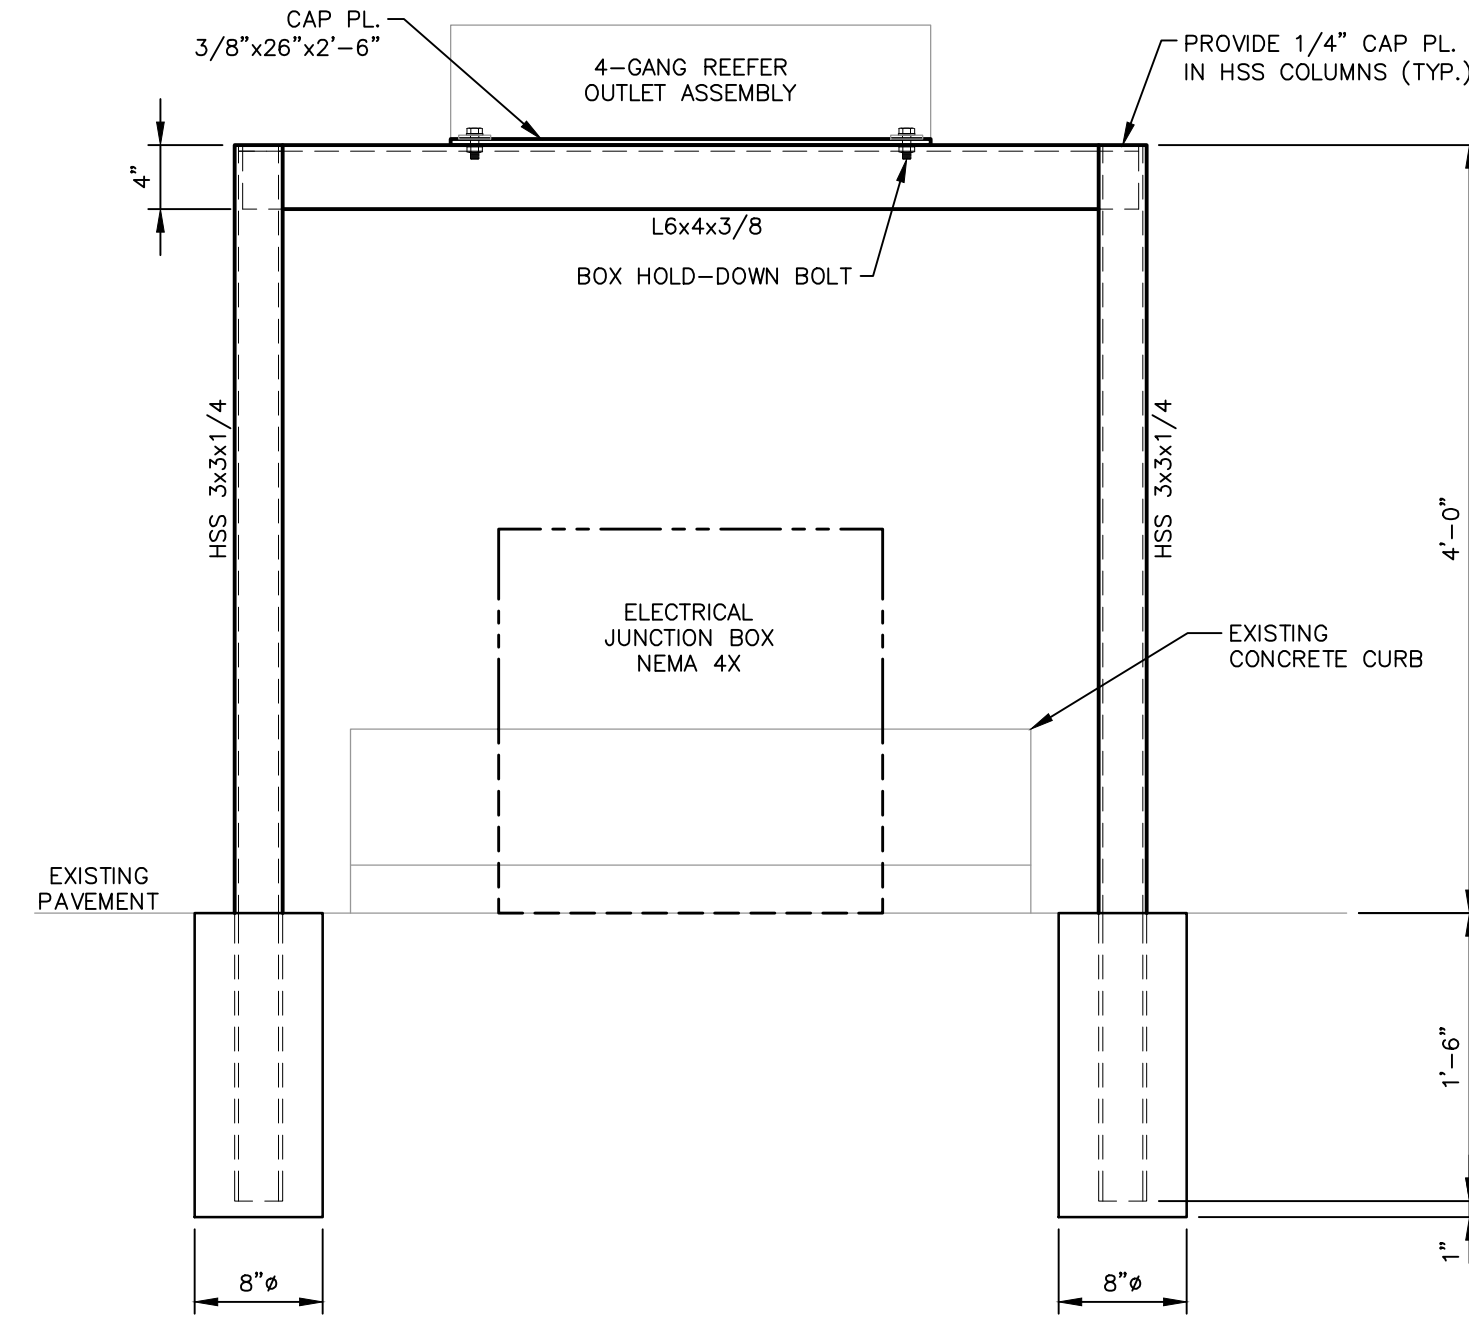

ELEVATION


SCALE: 1" = 1'-0"

1 REEFER PLUG PEDESTAL DETAIL

2

ELEVATED REEFER PLUG RENDERING (FOR REFERENCE ONLY)


NOT TO SCALE

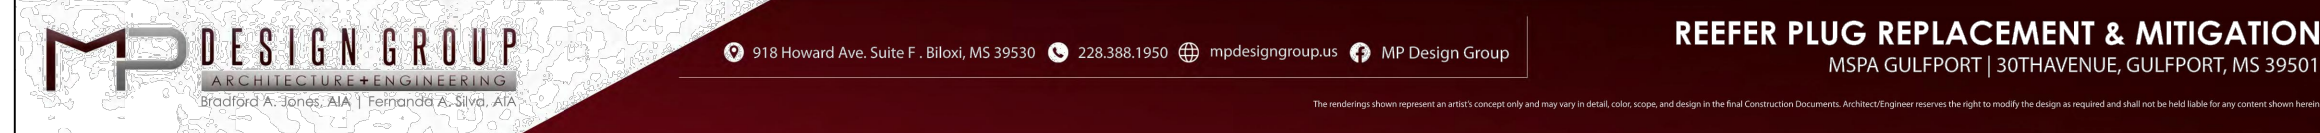

MP DESIGN GROUP
 ARCHITECTURE + ENGINEERING
 Bradford A. Spaul, AIA | Fernanda A. Silva, AIA

918 Howard Ave. Suite F, Biloxi, MS 39530 | 228.388.1950 | mpdesigngroup.com | MP Design Group

REEFER PLUG REPLACEMENT & MITIGATION
 MSPA GULFPORT | 30TH AVENUE, GULFPORT, MS 39501

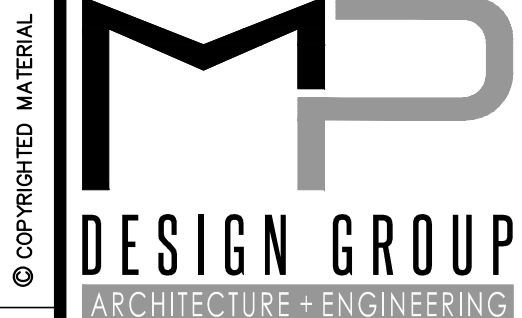

"Designed to Build"
 918 Howard Ave Suite F
 Biloxi, Mississippi 39530
 P: 228.388.1950
 www.mpdesigngroup.us

David J. Machado, PE
 Brad P. Patano, PE
 Gerrod W. Kilpatrick, PE
 Bradford A. Jones, AIA
 Fernanda A. Silva, AIA



ELEVATED REEFER PLUGS
 PORT OF GULFPORT MISSISSIPPI
 STATE PORT AUTHORITY
 30TH AVENUE
 GULFPORT, MS 39501

SCALE: AS INDICATED
 PROJECT NO: 0297.22.002
 DRAWN BY: NWM
 CHECKED BY: NWM

CIVIL SITE DETAILS

NO.	DATE	REVISION / SUBMITTAL
REV 0	4/13/2023	ISSUED FOR CONSTRUCTION
REV 1	5/12/2023	ADDENDUM 01

C620
 VERIFY SCALES
 BAR IS ONE INCH ON ORIGINAL DRAWING
 IF NOT ONE INCH ON THIS SHEET, ADJUST SCALES ACCORDINGLY

THE ORIGINAL SIGNED, DATED AND SEALED ENGINEERING PLANS ARE THE OFFICIAL DOCUMENTS SUBMITTED TO THE APPROVING AUTHORITY FOR THESE PLANS. CONTRACTOR / SUBCONTRACTOR / OWNER SHALL CONSULT ENGINEERED PLANS TO VERIFY ANY CONDITIONS OR RESTRICTIONS THAT MAY HAVE BEEN REQUIRED BY THE APPROVING AUTHORITY OR APPROVED BY THE REGISTERED ENGINEER OF RECORD. IF DISCREPANCIES OCCUR, THE ORIGINAL SIGNED, DATED AND SEALED ENGINEERED PLAN SET SHALL OVERRIDE ANY OTHER PLANS. THE DRAWINGS, DETAILS, AND NOTES THAT APPEAR ON THIS SHEET ARE COPYRIGHTED BY MACHADO | PATANO, PLLC, AND CLAIM ALL RIGHTS OF THE COPYRIGHT LAWS. © COPYRIGHTED MATERIAL

PRINTED: 5/12/2023 1:48 PM BY: Kenneth Beverin LAST SAVED: 5/12/2023 1:38 PM BY: Kbeverin m:\0297_mspc_gulfport\0297.22.003_work_order no 2 - reefer plug replacement & mitigation\06-electrical\02-production\01-production drawings\port of gulfport reefer plugs electrical.dwg

ABBREVIATIONS

A	AMPERE(S) ALTERNATING CURRENT AIR DRYER AIR CONDITIONING AMPERE FRAME ABOVE FINISHED FLOOR ABOVE FINISHED GRADE AMPERES INTERRUPTING CAPACITY ALUMINUM AMPERE TRIP AMERICAN WIRE GAGE AIR HANDLING UNIT	E	E.C. ELECTRICAL CONTRACTOR EEB ELECTRICAL EQUIPMENT BUILDING EF EXHAUST FAN EL ELEVATION EM EMERGENCY ESD EMERGENCY SHUTDOWN EWC ELECTRIC WATER COOLER EXIST EXISTING	K	THOUSAND CIRCULAR MILS KILOVOLT KILOVOLT.AMPERES KILOWATT	P	PHASE PULL BOX PANEL PAIR PHOTO ELECTRIC HEAT PUMP PRIMARY PASSIVE INFRARED POTENTIAL TRANSFORMER POLYVINYL CHLORIDE POWER	U	UNDERGROUND UNDERWRITER'S LABORATORIES
C	CONDUIT CIRCUIT BREAKER COMPRESSOR CIRCUIT CLASS CONDUCTOR(S) CURRENT TRANSFORMER COPPER COMMUNICATION CHILLED WATER PUMP	F	FC FOOT CANDLE FF FINISHED FLOOR FLA FULL LOAD AMPS FL FLUORESCENT FREQ. FREQUENCY FT. FOOT; FEET	L	LBS. POUNDS LEV LEVEL LTG. LIGHTING LV LOW VOLTAGE	R	RECEPTACLE REQUIRED RIGID GALVANIZED STEEL ROOM RAINTIGHT	V	VOLTS VOLTAGE, ALTERNATING CURRENT VOLTAGE, DIRECT CURRENT
D	DIRECT CURRENT DETECTOR	G	GALV GALVANIZED GFI GROUND FAULT INTERRUPTER GND GROUND	M	MCB MAIN CIRCUIT BREAKER MISC MISCELLANEOUS MLO MAIN LUGS ONLY MTD MOUNTED MH MOUNTING HEIGHT	S	SECONDARY SMOKE SINGLE POINT CONNECTION SUNRISE SUNSET STANDARD SUPERVISORY SWBD SWITCHBOARD	W	WATTS, WIRE, WIDTH WEATHERPROOF
J	JUNCTION BOX	H	HP HORSEPOWER HPS HIGH PRESSURE SODIUM HV HIGH VOLTAGE HZ HERTZ	N	NEUTRAL ELECTRICAL CODE N.C. NORMALLY CLOSED N.O. NORMALLY OPEN NF NONFUSED NFPA NATIONAL FIRE PROTECTION ASSOCIATION NL UN SWITCHED NIGHT LIGHT NTS NOT TO SCALE	T	TYPICAL	X	TRANSFORMER
O	ON CENTER OVERLOAD CONTACT	J		O		T		X	

EQUIPMENT BY OTHERS

THE FOLLOWING EQUIPMENT SHALL BE SUPPLIED BY THE OWNER, INSTALLED AND COMMISSIONED BY THE CONTRACTOR. CONTRACTOR SHALL INSTALL PER SPECIFICATIONS AND EQUIPMENT DOCUMENTATION FOR A COMPLETE AND OPERABLE SYSTEM:

- REEFER PLUGS
- 2-GANG REEFER OUTLET ASSEMBLY, 480VAC, 3-PHASE, 3-WIRE, 60 AMP. NOTE THAT RR3N-16 IS A 35 KAIC RATED REEFER OUTLET ASSEMBLY AND RR3N-17 IS A 65 KAIC RATED REEFER OUTLET ASSEMBLY.
- 4-GANG REEFER OUTLET ASSEMBLY, 480VAC, 3-PHASE, 3-WIRE, 120 AMP.

CONTRACTOR SHALL PROVIDE ALL MISC. EQUIPMENT REQUIRED FOR A COMPLETE AND OPERABLE SYSTEM.

LOCK OUT/TAG OUT

CONTRACTOR SHALL DEVELOP A LOCK OUT/TAG OUT PLAN AND SUBMIT TO THE PORT OF GULFPORT FOR REVIEW AND APPROVAL PRIOR TO STARTING WORK.

REEFER OUTLET ASSEMBLY LABELING


CONTRACTOR SHALL PROVIDE AND INSTALL THE FOLLOWING LABELING ON EACH REEFER OUTLET ASSEMBLY:

- REEFER OUTLET ASSEMBLY NUMBER AND CIRCUIT NUMBER - CONTRACTOR SHALL MATCH INFORMATION ON EXISTING REEFER OUTLET ASSEMBLIES.
- ARC FAULT STICKER - CONTRACTOR SHALL MATCH INFORMATION ON EXISTING REEFER OUTLET ASSEMBLIES.
- CONDUCTOR LABELING - CONTRACTOR SHALL MATCH EXISTING CONDUCTOR LABELING.

FEEDER SCHEDULE


TYPE THHN/THWN INSUL. COPPER CONDUCTOR AMPACITY BASED ON (75° TEMP. RATING) IN RIGID METAL CONDUIT
FOR REEFER OUTLET ASSEMBLIES: XHHW-2 TYPE TC CABLE BASED ON (90° TEMP. RATING) IN RIGID METAL CONDUIT
 DRY INTERIOR LOCATIONS: EMT WITH CAST COMPRESSION FITTINGS
 WET EXTERIOR LOCATIONS: RGS WITH CAST FITTINGS
 UNDERGROUND INSTALLATIONS: SCHEDULE 80 PVC BELOW SLAB OR CONCRETE ENCASED. FIBERGLASS ELSEWHERE.

FEEDER DESIGNATION	3PH+G PHASE + GND. CONDUCTORS AND CONDUIT SIZE	FEEDER DESIGNATION	3PH+N+G PHASE + NEUTRAL + GND. CONDUCTORS AND CONDUIT SIZE	FEEDER DESIGNATION	2 WIRE + NEUTRAL + GND. OR 2 WIRE + GND. OR 1 WIRE + NEUTRAL + GND. CONDUCTORS AND CONDUIT SIZE
(20)	3#12+#12 GND., 3/4"C	(20N)	4#12+#12 GND., 3/4"C	(20S)	2#12+#12 GND., 3/4"C
(30)	3#10+#10 GND., 3/4"C	(30N)	4#10+#10 GND., 3/4"C	(30S)	2#10+#10 GND., 3/4"C
(50)	3#8+#10 GND., 1"C	(50N)	4#8+#10 GND., 1"C	(50S)	2#8+#10 GND., 1"C
(65)	3#6+#8 GND., 1"C	(65N)	4#6+#8 GND., 1 1/4"C	(65S)	2#6+#8 GND., 1"C
(85)	3#4+#8 GND., 1 1/4"C	(85N)	4#4+#8 GND., 1 1/4"C	(85S)	2#4+#8 GND., 1 1/4"C
(100)	3#3+#8 GND., 1 1/4"C	(100N)	4#3+#8 GND., 1 1/2"C	(100S)	2#3+#8 GND., 1 1/4"C
(115)	3#2+#6 GND., 1 1/2"C	(115N)	4#2+#6 GND., 1 1/2"C	(115S)	2#2+#6 GND., 1 1/2"C
(130)	3#1+#6 GND., 1 1/2"C	(130N)	4#1+#6 GND., 2"C	(130S)	2#1+#6 GND., 1 1/2"C
(150)	3#1/0+#6 GND., 2"C	(150N)	4#1/0+#6 GND., 2"C	(150S)	2#1/0+#6 GND., 2"C
(175)	3#2/0+#6 GND., 2"C	(175N)	4#2/0+#6 GND., 2 1/2"C	(175S)	2#2/0+#6 GND., 2"C
(200)	3#3/0+#6 GND., 2"C	(200N)	4#3/0+#6 GND., 2 1/2"C	(200S)	2#3/0+#6 GND., 2"C
(230)	3#3/0+#4 GND., 2"C	(230N)	4#4/0+#4 GND., 3"C	(230S)	2#4/0+#4 GND., 2 1/2"C
(255)	3#250+#4 GND., 2 1/2"C	(255N)	4#250+#4 GND., 3"C	(255S)	2#250+#4 GND., 2 1/2"C
(285)	3#300+#4 GND., 3"C	(285N)	4#300+#4 GND., 3"C	(285S)	2#300+#4 GND., 3"C
(310)	3#350+#3 GND., 3"C	(310N)	4#350+#3 GND., 4"C	(310S)	2#350+#3 GND., 3"C
(335)	3#400+#3 GND., 3"C	(335N)	4#400+#3 GND., 4"C	(335S)	2#400+#3 GND., 4"C
(380)	3#500+#3 GND., 4"C	(380N)	4#500+#3 GND., 4"C	(380S)	2#500+#3 GND., 4"C
(400)	2 SETS(3#3/0+#3 GND., 2"C)	(400N)	2 SETS(4#3/0+#3 GND., 2 1/2"C)		
(420)	3#600+#2 GND., 4"C	(420N)	4#600+#2 GND., 4"C		
(460)	2 SETS(3#4/0+#2 GND., 2"C)	(460N)	2 SETS(4#4/0+#2 GND., 2 1/2"C)		
(510)	2 SETS(3#250+#1 GND., 2 1/2"C)	(510N)	2 SETS(4#250+#1 GND., 3"C)		
(570)	2 SETS(3#300+#4 GND., 2 1/2"C)	(570N)	2 SETS(4#300+#4 GND., 3"C)		
(620)	2 SETS(3#350+#1/0 GND., 3"C)	(620N)	2 SETS(4#350+#1/0 GND., 3"C)		
(760)	2 SETS(3#500+#1/0 GND., 3"C)	(760N)	2 SETS(4#500+#1/0 GND., 4"C)		
(840)	2 SETS(3#600+#2/0 GND., 4"C)	(840N)	2 SETS(4#600+#2/0 GND., 4"C)		
(855)	3 SETS(3#300+#2/0 GND., 2 1/2"C)	(855N)	3 SETS(4#300+#2/0 GND., 3"C)		
(1005)	3 SETS(3#400+#3/0 GND., 3"C)	(1005N)	3 SETS(4#400+#3/0 GND., 3"C)		
(1240)	4 SETS(3#350+#4/0 GND., 3"C)	(1240N)	4 SETS(4#350+#4/0 GND., 4"C)		
(1650)	5 SETS(3#400+#250 GND., 3"C)	(1650N)	5 SETS(4#400+#250 GND., 4"C)		
(2010)	6 SETS(3#400+#350 GND., 3"C)	(2010N)	6 SETS(4#400+#350 GND., 4"C)		
(2660)	7 SETS(3#500+#450 GND., 4"C)	(2660N)	7 SETS(4#500+#400 GND., 4"C)		
(3040)	8 SETS(3#500+#500 GND., 4"C)	(3040N)	8 SETS(4#500+#500 GND., 4"C)		
(4180)	11 SETS(3#500+#700 GND., 4"C)	(4180N)	11 SETS(4#500+#700 GND., 4"C)		
(MV500)	3 #500 KCMIL+#4/0 GND., 5"C				

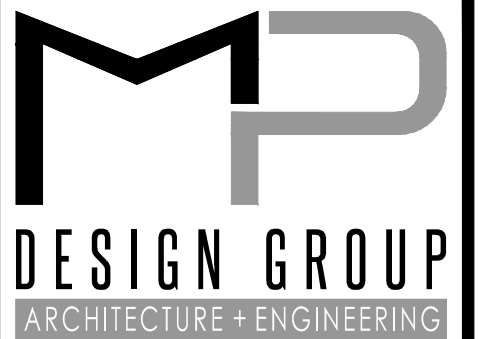

"Designed to Build"
 918 Howard Ave Suite F
 Biloxi, Mississippi 39530
 P: 228.388.1950
 www.mpdesigngroup.us

David J. Machado, PE
 Brad P. Patano, PE
 Gerrod W. Kilpatrick, PE
 Bradford A. Jones, AIA
 Fernanda A. Silva, AIA

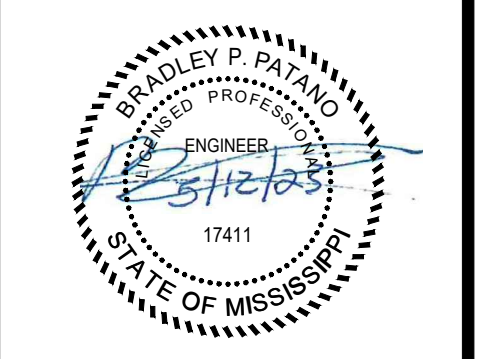

ELEVATED REEFER PLUGS
 PORT OF GULFPORT MISSISSIPPI
 STATE PORT AUTHORITY
 30TH AVENUE
 GULFPORT, MS 39501

SCALE: NOT TO SCALE
 PROJECT NO: 0297.22.002
 DRAWN BY: KDB
 CHECKED BY: KDB

ELECTRICAL ABBREVIATIONS & SCHEDULES

NO.	DATE	REVISION / SUBMITTAL
REV 0	4/13/2023	ISSUED FOR CONSTRUCTION
REV 1	5/12/2023	ADDENDUM 1

E002


VERIFY SCALES
 BAR IS ONE INCH ON ORIGINAL DRAWING
 IF NOT ONE INCH ON THIS SHEET, ADJUST SCALES ACCORDINGLY

© COPYRIGHTED MATERIAL. THE ORIGINAL SIGNED, DATED AND SEALED ENGINEERING PLANS ARE THE OFFICIAL DOCUMENTS SUBMITTED TO THE APPROVING AUTHORITY FOR THESE PLANS. CONTRACTOR / SUBCONTRACTOR / AND/OR OWNER SHALL CONSULT ENGINEERED PLANS TO VERIFY ANY CONDITIONS OR RESTRICTIONS THAT MAY HAVE BEEN REQUIRED BY THE APPROVING AUTHORITY OR APPROVED BY THE REGISTERED ENGINEER OF RECORD. IF DISCREPANCIES OCCUR, THE ORIGINAL SIGNED, DATED AND SEALED ENGINEERED PLAN SET SHALL OVERRIDE ANY OTHER PLANS, THE DRAWINGS, DETAILS, AND NOTES THAT APPEAR ON THIS SHEET ARE COPYRIGHTED BY MACHADO | PATANO, PLLC, AND CLAIM ALL RIGHTS OF THE COPYRIGHT LAWS.

TO
UTILITY
TRANSFORMERS

4180N

MSB-11A (SECTION 1 & SECTION 2 PARTIAL)
 480/277V, 3Ø, 4W,
 4,000A MCB, 65,000 AIC, NEMA 3R
 LOCATION: PLATFORM 11, TOTAL CONNECTED LOAD = UNKNOWN

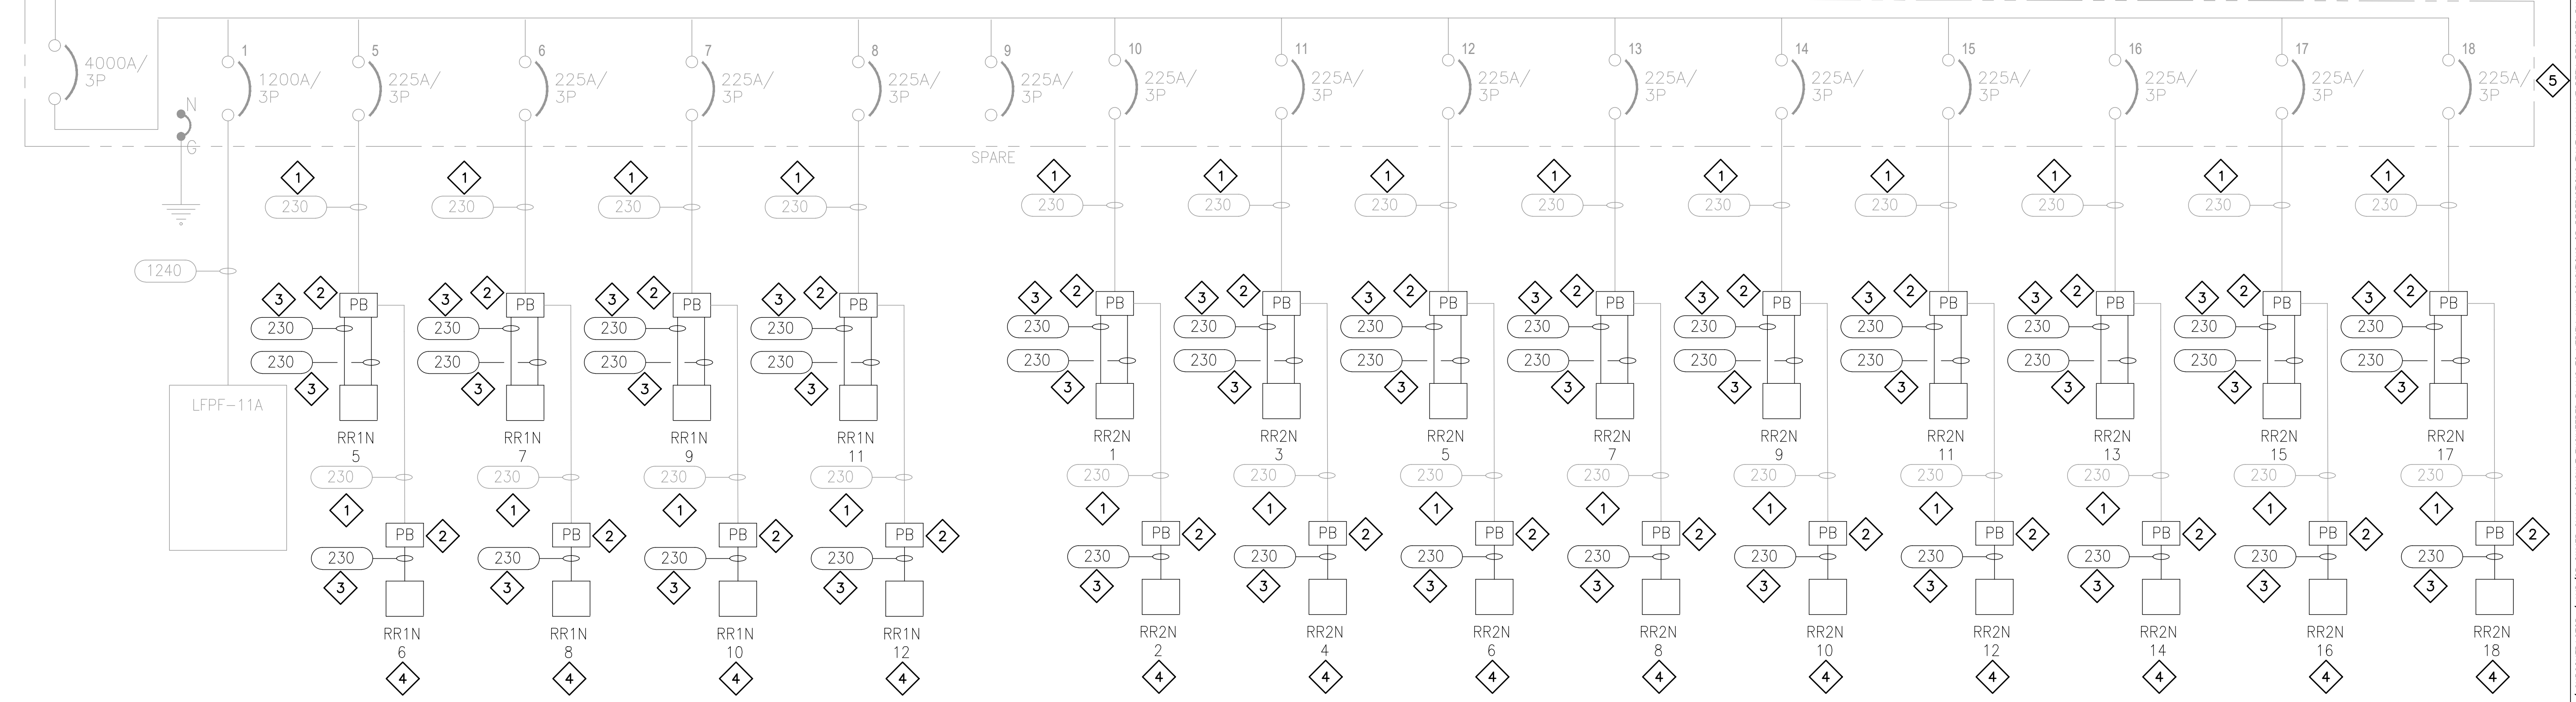


SHEET E601 LEGEND

230 - 3-#3/0 AWG + 1-#4 AWG (G) XHHW-2 TYPE TC CONDUCTOR


DRAWING E601 SPECIFIC NOTES

- 1 EXISTING FEEDER TO REMAIN AS-IS.
- 2 CONTRACTOR SHALL PROVIDE AND INSTALL PULLBOX/SPLICE BOX. SEE SHEET E501 FOR DETAILS.
- 3 CONTRACTOR SHALL EXTEND FEEDER TO NEW ELEVATED REEFER OUTLET. NEW CONDUCTOR SHALL BE ROUTED IN RGS CONDUIT. SPLICES SHALL BE MADE WATER-TIGHT. SEE SHEET E501 FOR DETAILS.
- 4 NEW REEFER OUTLETS (PROVIDED BY OWNER, INSTALLED BY CONTRACTOR) SHALL BE ON ELEVATED PLATFORM. CONTRACTOR SHALL NOTE THAT MULTIPLE REEFER OUTLETS ARE ON A SINGLE CIRCUIT. SEE CIVIL/STRUCTURAL SHEETS FOR PLATFORM DETAILS. PLATFORMS SHALL BE PROVIDED AND INSTALLED BY CONTRACTOR.
- 5 CONTINUE ON SHEET E602.

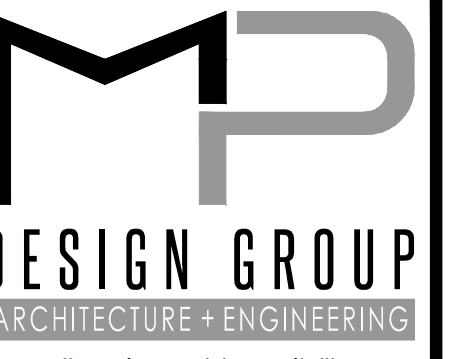

"Designed to Build"
 918 Howard Ave Suite F
 Biloxi, Mississippi 39530
 P: 228.388.1950
 www.mpdesigngroup.us

David J. Machado, PE
 Brad P. Patano, PE
 Gerrod W. Kilpatrick, PE
 Bradford A. Jones, AIA
 Fernanda A. Silva, AIA

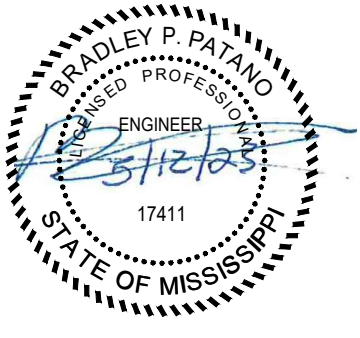

ELEVATED REEFER PLUGS

PORT OF GULFPORT MISSISSIPPI

STATE PORT AUTHORITY

30TH AVENUE

GULFPORT, MS 39501

SCALE: NOT TO SCALE
 PROJECT NO: 0297.22.002
 DRAWN BY: KDB
 CHECKED BY: KDB

ELECTRICAL ONE-LINE DIAGRAM

NO.	DATE	REVISION / SUBMITTAL
REV.0	4/13/2023	ISSUED FOR CONSTRUCTION
REV.1	5/12/2023	ADDENDUM 1

E601

VERIFY SCALES
 BAR IS ONE INCH ON ORIGINAL DRAWING
 IF NOT ONE INCH ON THIS SHEET, ADJUST
 SCALES ACCORDINGLY

THE ORIGINAL SIGNED, DATED AND SEALED ENGINEERING PLANS ARE THE OFFICIAL DOCUMENTS SUBMITTED TO THE APPROVING AUTHORITY FOR THESE PLANS. CONTRACTOR / SUBCONTRACTOR / AND/OR OWNER SHALL CONSULT ENGINEERED PLANS TO VERIFY ANY CONDITIONS OR RESTRICTIONS THAT MAY HAVE BEEN REQUIRED BY THE APPROVING AUTHORITY OR APPROVED BY THE REGISTERED ENGINEER OF RECORD. IF DISCREPANCIES OCCUR, THE ORIGINAL SIGNED, DATED AND SEALED ENGINEERING PLAN SET SHALL OVERRIDE ANY OTHER PLANS, THE DRAWINGS, DETAILS, AND NOTES THAT APPEAR ON THIS SHEET ARE COPYRIGHTED BY MACHADO | PATANO, PLLC, AND CLAIM ALL RIGHTS OF THE COPYRIGHT LAWS. © COPYRIGHTED MATERIAL

PRINTED: 5/12/2023 1:48 PM BY: Kenneth Beverin LAST SAVED: 5/12/2023 1:38 PM BY: Kbeverin
 m:\0297_mspc_gulport\0297.22.003_work_order no 2 - reefer plug replacement & mitigation\06-electrical\02-production drawings\port of gulport reefer plugs electrical.dwg



SHEET E602 LEGEND

230 - 3-#3/0 AWG + 1-#4 AWG (G) XHHW-2 TYPE TC CONDUCTOR


DRAWING E602 SPECIFIC NOTES

- 1 EXISTING FEEDER TO REMAIN AS-IS.
- 2 CONTRACTOR SHALL PROVIDE AND INSTALL PULLBOX/SPLICE BOX. SEE SHEET E501 FOR DETAILS.
- 3 CONTRACTOR SHALL EXTEND FEEDER TO NEW ELEVATED REEFER OUTLET. NEW CONDUCTOR SHALL BE ROUTED IN RGS CONDUIT. SPLICES SHALL BE MADE WATER-TIGHT. SEE SHEET E501 FOR DETAILS.
- 4 NEW REEFER OUTLETS (PROVIDED BY OWNER, INSTALLED BY CONTRACTOR) SHALL BE ON ELEVATED PLATFORM. CONTRACTOR SHALL NOTE THAT MULTIPLE REEFER OUTLETS ARE ON A SINGLE CIRCUIT. SEE CIVIL/STRUCTURAL SHEETS FOR PLATFORM DETAILS. PLATFORMS SHALL BE PROVIDED AND INSTALLED BY CONTRACTOR.
- 5 CONTINUE ON SHEET E601.

MSB-11A (SECTION 2 PARTIAL AND SECTION 3 PARTIAL)
 480/277V, 3Ø, 4W,
 4,000A MCB, 65,000 AIC, NEMA 3R
 LOCATION: PLATFORM 11, TOTAL CONNECTED LOAD = UNKNOWN

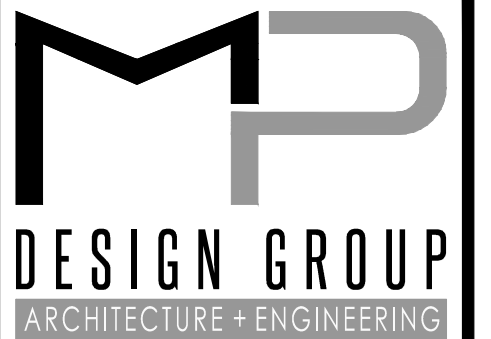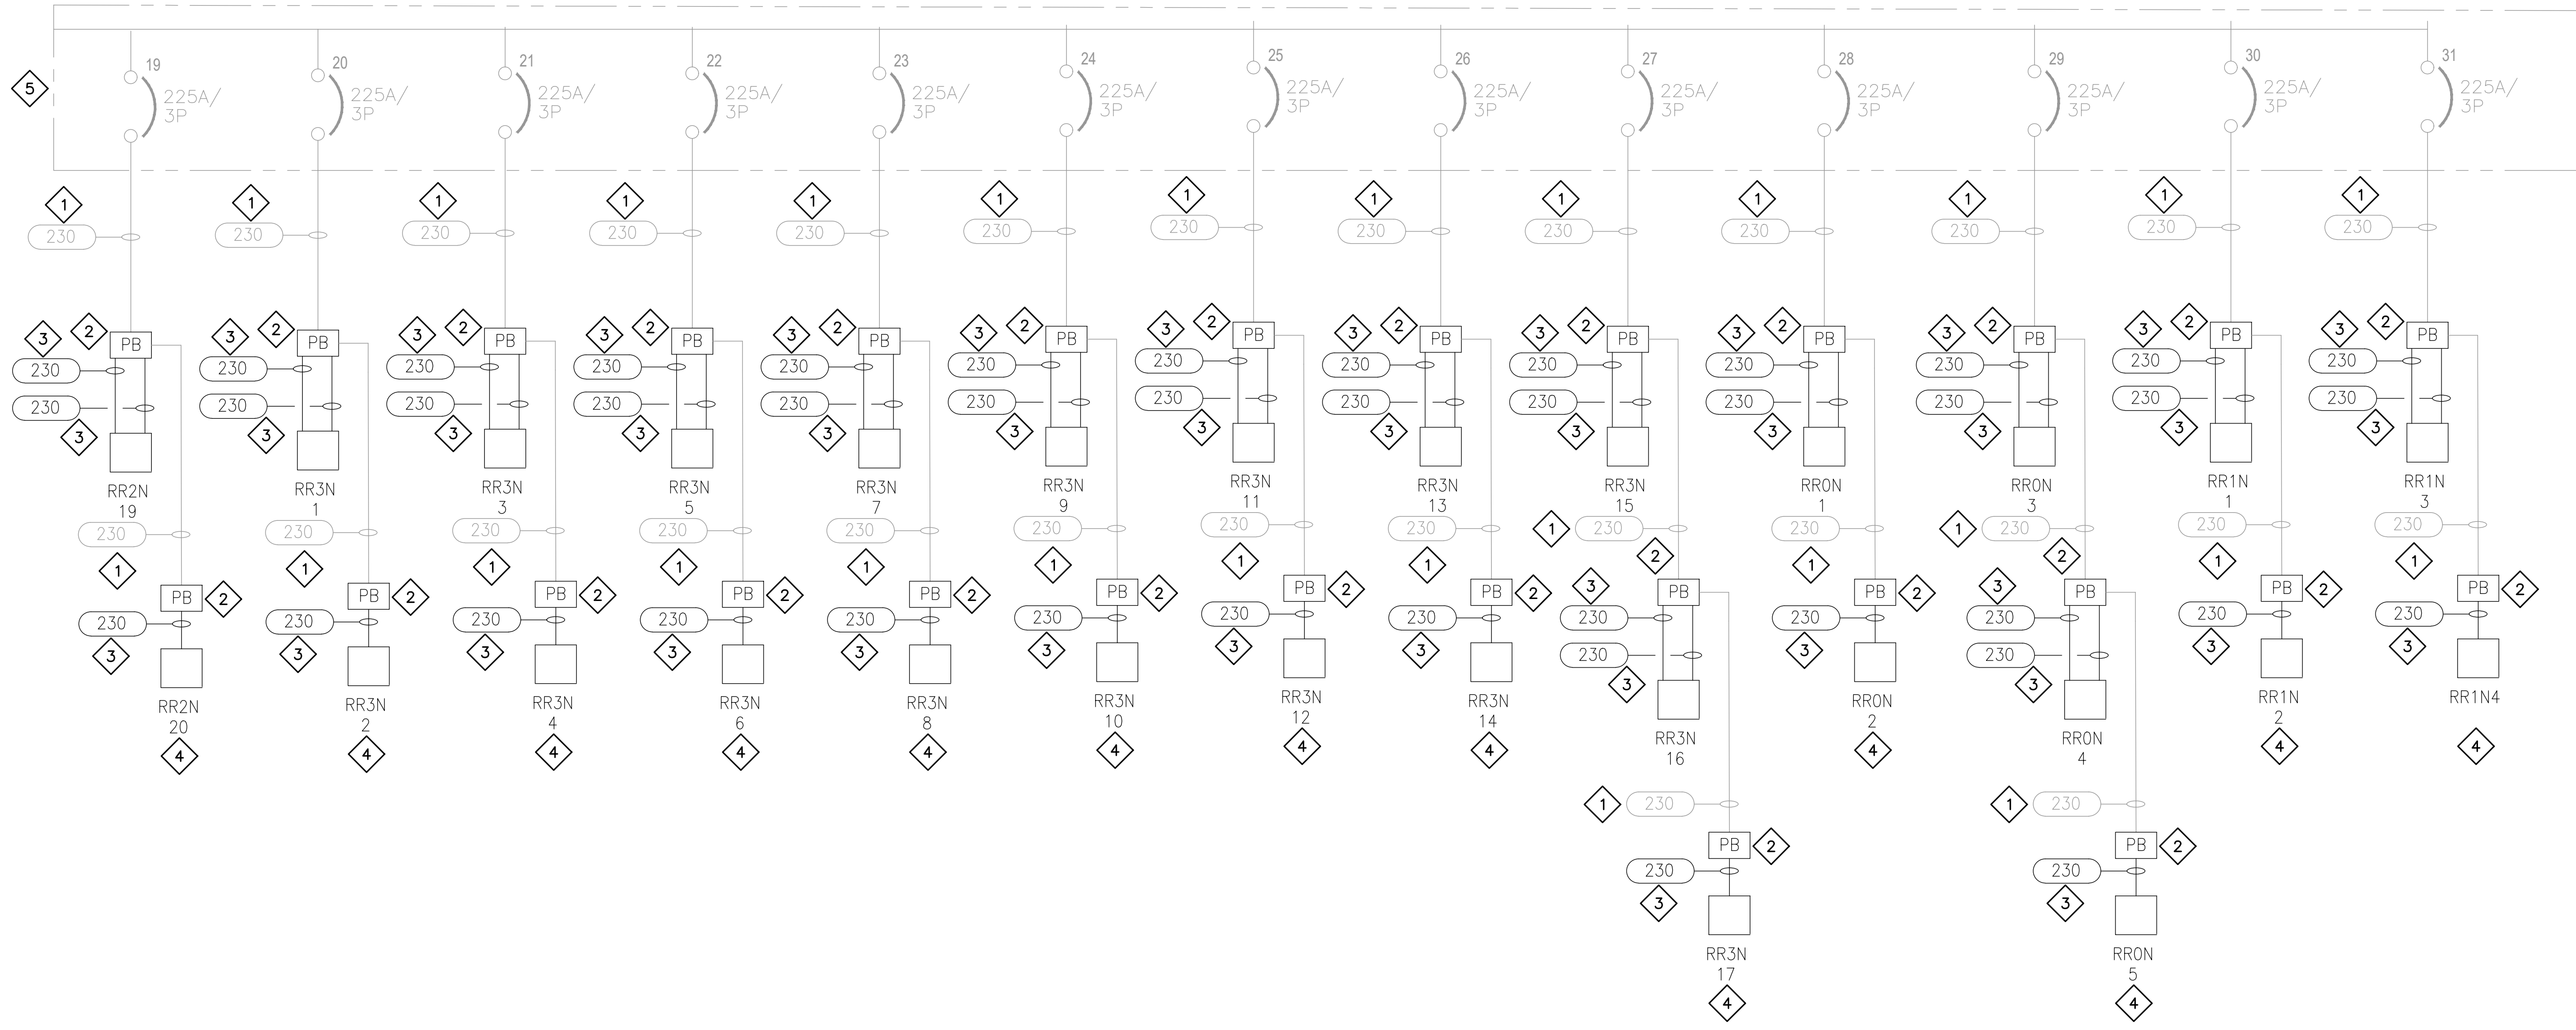

"Designed to Build"
 918 Howard Ave Suite F
 Biloxi, Mississippi 39530
 P: 228.388.1950
 www.mpdesigngroup.us
 David J. Machado, PE
 Brad P. Patano, PE
 Gerrod W. Kilpatrick, PE
 Bradford A. Jones, AIA
 Fernanda A. Silva, AIA

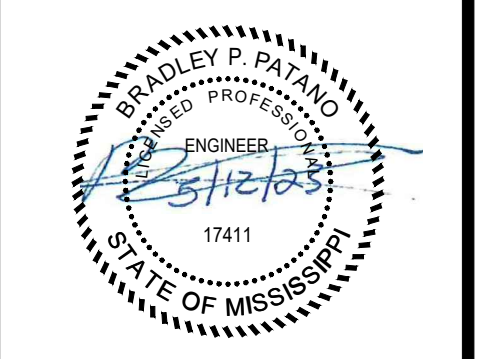

ELEVATED REEFER PLUGS
PORT OF GULFPORT MISSISSIPPI
STATE PORT AUTHORITY
 30TH AVENUE
 GULFPORT, MS 39501

SCALE: NOT TO SCALE
 PROJECT NO: 0297.22.002
 DRAWN BY: KDB
 CHECKED BY: KDB

ELECTRICAL ONE-LINE DIAGRAM

NO.	DATE	REVISION / SUBMITTAL
REV 0	4/13/2023	ISSUED FOR CONSTRUCTION
REV 1	5/12/2023	ADDENDUM 1


E602
 VERIFY SCALES
 BAR IS ONE INCH ON ORIGINAL DRAWING
 IF NOT ONE INCH ON THIS SHEET, ADJUST SCALES ACCORDINGLY

THE ORIGINAL SIGNED, DATED AND SEALED ENGINEERING PLANS ARE THE OFFICIAL DOCUMENTS SUBMITTED TO THE APPROVING AUTHORITY FOR THESE PLANS. CONTRACTOR / SUBCONTRACTOR / AND/OR OWNER SHALL CONSULT ENGINEERED PLANS TO VERIFY ANY CONDITIONS OR RESTRICTIONS THAT MAY HAVE BEEN REQUIRED BY THE APPROVING AUTHORITY OR APPROVED BY THE REGISTERED ENGINEER OF RECORD. IF DISCREPANCIES OCCUR, THE ORIGINAL SIGNED, DATED AND SEALED ENGINEERED PLAN SET SHALL OVERRIDE ANY OTHER PLANS, THE DRAWINGS, DETAILS, AND NOTES THAT APPEAR ON THIS SHEET ARE COPYRIGHTED BY MACHADO | PATANO, PLLC, AND CLAIM ALL RIGHTS OF THE COPYRIGHT LAWS. © COPYRIGHTED MATERIAL

PRINTED: 5/12/2023 1:49 PM BY: Kenneth Beverin LAST SAVED: 5/12/2023 1:38 PM BY: Kbeverin
 m:\0297_mspc_gulport\0297.22.003_work_order no 2 - reefer plug replacement & mitigation\06-electrical\02-production drawings\port of gulport reefer plugs electrical.dwg

TO
UTILITY
TRANSFORMERS

4180N
 MSB-11B (SECTION 1 & SECTION 2 PARTIAL)
 480/277V, 3Ø, 4W,
 4,000A MCB, 65,000 AIC, NEMA 3R
 LOCATION: PLATFORM 11, TOTAL CONNECTED LOAD = UNKNOWN

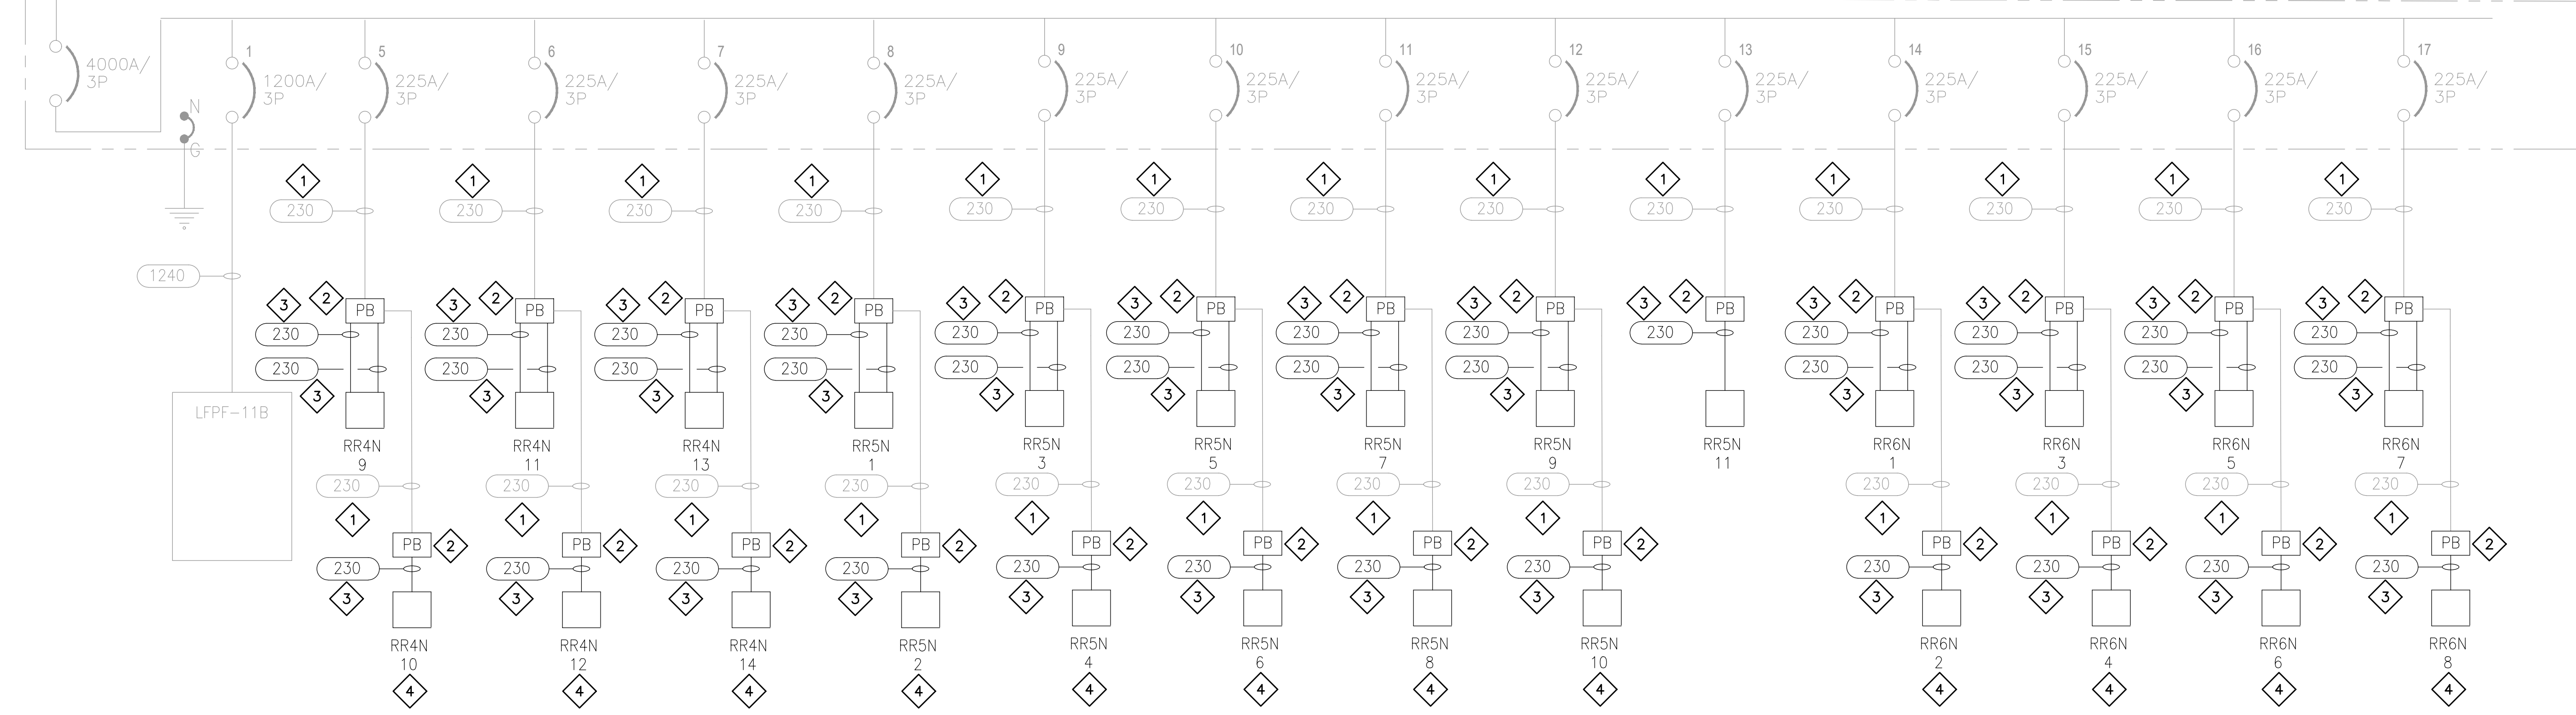


SHEET E603 LEGEND


230 - 3-#3/0 AWG + 1-#4 AWG (G) XHHW-2 TYPE TC CONDUCTOR

DRAWING E603 SPECIFIC NOTES

- 1 EXISTING FEEDER TO REMAIN AS-IS.
- 2 CONTRACTOR SHALL PROVIDE AND INSTALL PULLBOX/SPLICE BOX. SEE SHEET E501 FOR DETAILS.
- 3 CONTRACTOR SHALL EXTEND FEEDER TO NEW ELEVATED REEFER OUTLET. NEW CONDUCTOR SHALL BE ROUTED IN RGS CONDUIT. SPLICES SHALL BE MADE WATER-TIGHT. SEE SHEET E501 FOR DETAILS.
- 4 NEW REEFER OUTLETS (PROVIDED BY OWNER, INSTALLED BY CONTRACTOR) SHALL BE ON ELEVATED PLATFORM. CONTRACTOR SHALL NOTE THAT MULTIPLE REEFER OUTLETS ARE ON A SINGLE CIRCUIT. SEE CIVIL/STRUCTURAL SHEETS FOR PLATFORM DETAILS. PLATFORMS SHALL BE PROVIDED AND INSTALLED BY CONTRACTOR.
- 5 CONTINUE ON SHEET E604.

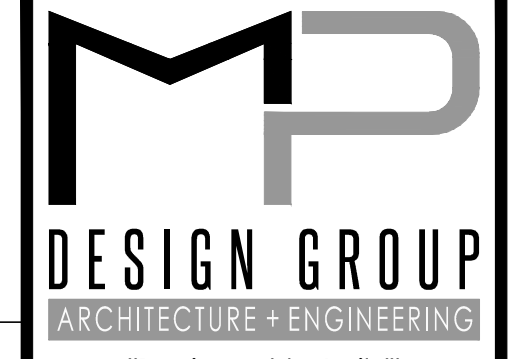

"Designed to Build"
 918 Howard Ave Suite F
 Biloxi, Mississippi 39530
 P: 228.388.1950
 www.mpdesigngroup.us
 David J. Machado, PE
 Brad P. Patano, PE
 Gerrod W. Kilpatrick, PE
 Bradford A. Jones, AIA
 Fernanda A. Silva, AIA

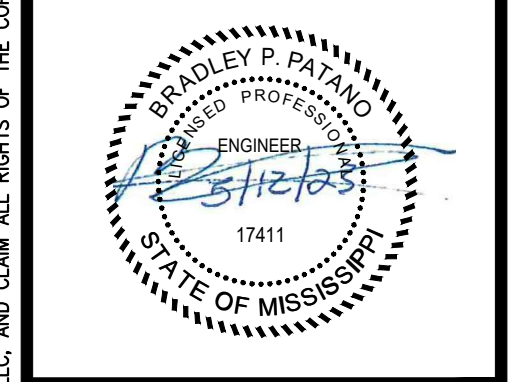

ELEVATED REEFER PLUGS
PORT OF GULFPORT MISSISSIPPI
STATE PORT AUTHORITY
 30TH AVENUE
 GULFPORT, MS 39501

SCALE: NOT TO SCALE
 PROJECT NO: 0297.22.002
 DRAWN BY: KDB
 CHECKED BY: KDB

ELECTRICAL ONE-LINE DIAGRAM

NO.	DATE	REVISION / SUBMITTAL
REV 0	4/13/2023	ISSUED FOR CONSTRUCTION
REV 1	5/12/2023	ADDENDUM 1

E603
 VERIFY SCALES
 BAR IS ONE INCH ON ORIGINAL DRAWING
 IF NOT ONE INCH ON THIS SHEET, ADJUST SCALES ACCORDINGLY

THE ORIGINAL SIGNED, DATED AND SEALED ENGINEERING PLANS ARE THE OFFICIAL DOCUMENTS SUBMITTED TO THE APPROVING AUTHORITY FOR THESE PLANS. CONTRACTOR / SUBCONTRACTOR / AND/OR OWNER SHALL CONSULT ENGINEERED PLANS TO VERIFY ANY CONDITIONS OR RESTRICTIONS THAT MAY HAVE BEEN REQUIRED BY THE APPROVING AUTHORITY OR APPROVED BY THE REGISTERED ENGINEER OF RECORD. IF DISCREPANCIES OCCUR, THE ORIGINAL SIGNED, DATED AND SEALED ENGINEERED PLAN SET SHALL OVERRIDE ANY OTHER PLANS, THE DRAWINGS, DETAILS, AND NOTES THAT APPEAR ON THIS SHEET ARE COPYRIGHTED BY MACHADO | PATANO, PLLC, AND CLAIM ALL RIGHTS OF THE COPYRIGHT LAWS. © COPYRIGHTED MATERIAL

PRINTED: 5/12/2023 1:49 PM BY: Kenneth Beverin LAST SAVED: 5/12/2023 1:38 PM BY: Kbeverin
 m:\0297_mspc_gulfport\0297.22.003_work_order no 2 - reefer plug replacement & mitigation\06-electrical\02-production drawings\port of gulfport reefer plugs electrical.dwg



SHEET E604 LEGEND

230 - 3-#3/0 AWG + 1-#4 AWG (G) XHHW-2 TYPE TC CONDUCTOR


DRAWING E604 SPECIFIC NOTES

- 1 EXISTING FEEDER TO REMAIN AS-IS.
- 2 CONTRACTOR SHALL PROVIDE AND INSTALL PULLBOX/SPLICE BOX. SEE SHEET E501 FOR DETAILS.
- 3 CONTRACTOR SHALL EXTEND FEEDER TO NEW ELEVATED REEFER OUTLET. NEW CONDUCTOR SHALL BE ROUTED IN RGS CONDUIT. SPLICES SHALL BE MADE WATER-TIGHT. SEE SHEET E501 FOR DETAILS.
- 4 NEW REEFER OUTLETS (PROVIDED BY OWNER, INSTALLED BY CONTRACTOR) SHALL BE ON ELEVATED PLATFORM. CONTRACTOR SHALL NOTE THAT MULTIPLE REEFER OUTLETS ARE ON A SINGLE CIRCUIT. SEE CIVIL/STRUCTURAL SHEETS FOR PLATFORM DETAILS. PLATFORMS SHALL BE PROVIDED AND INSTALLED BY CONTRACTOR.
- 5 CONTINUE ON SHEET E603.

MSB-11B (SECTION 2 PARTIAL)
 480/277V, 3Ø, 4W,
 4,000A MCB, 65,000 AIC, NEMA 3R
 LOCATION: PLATFORM 11, TOTAL CONNECTED LOAD = UNKNOWN

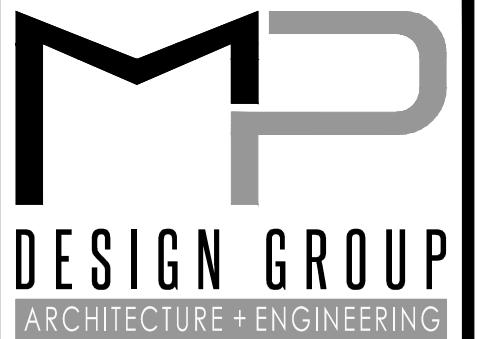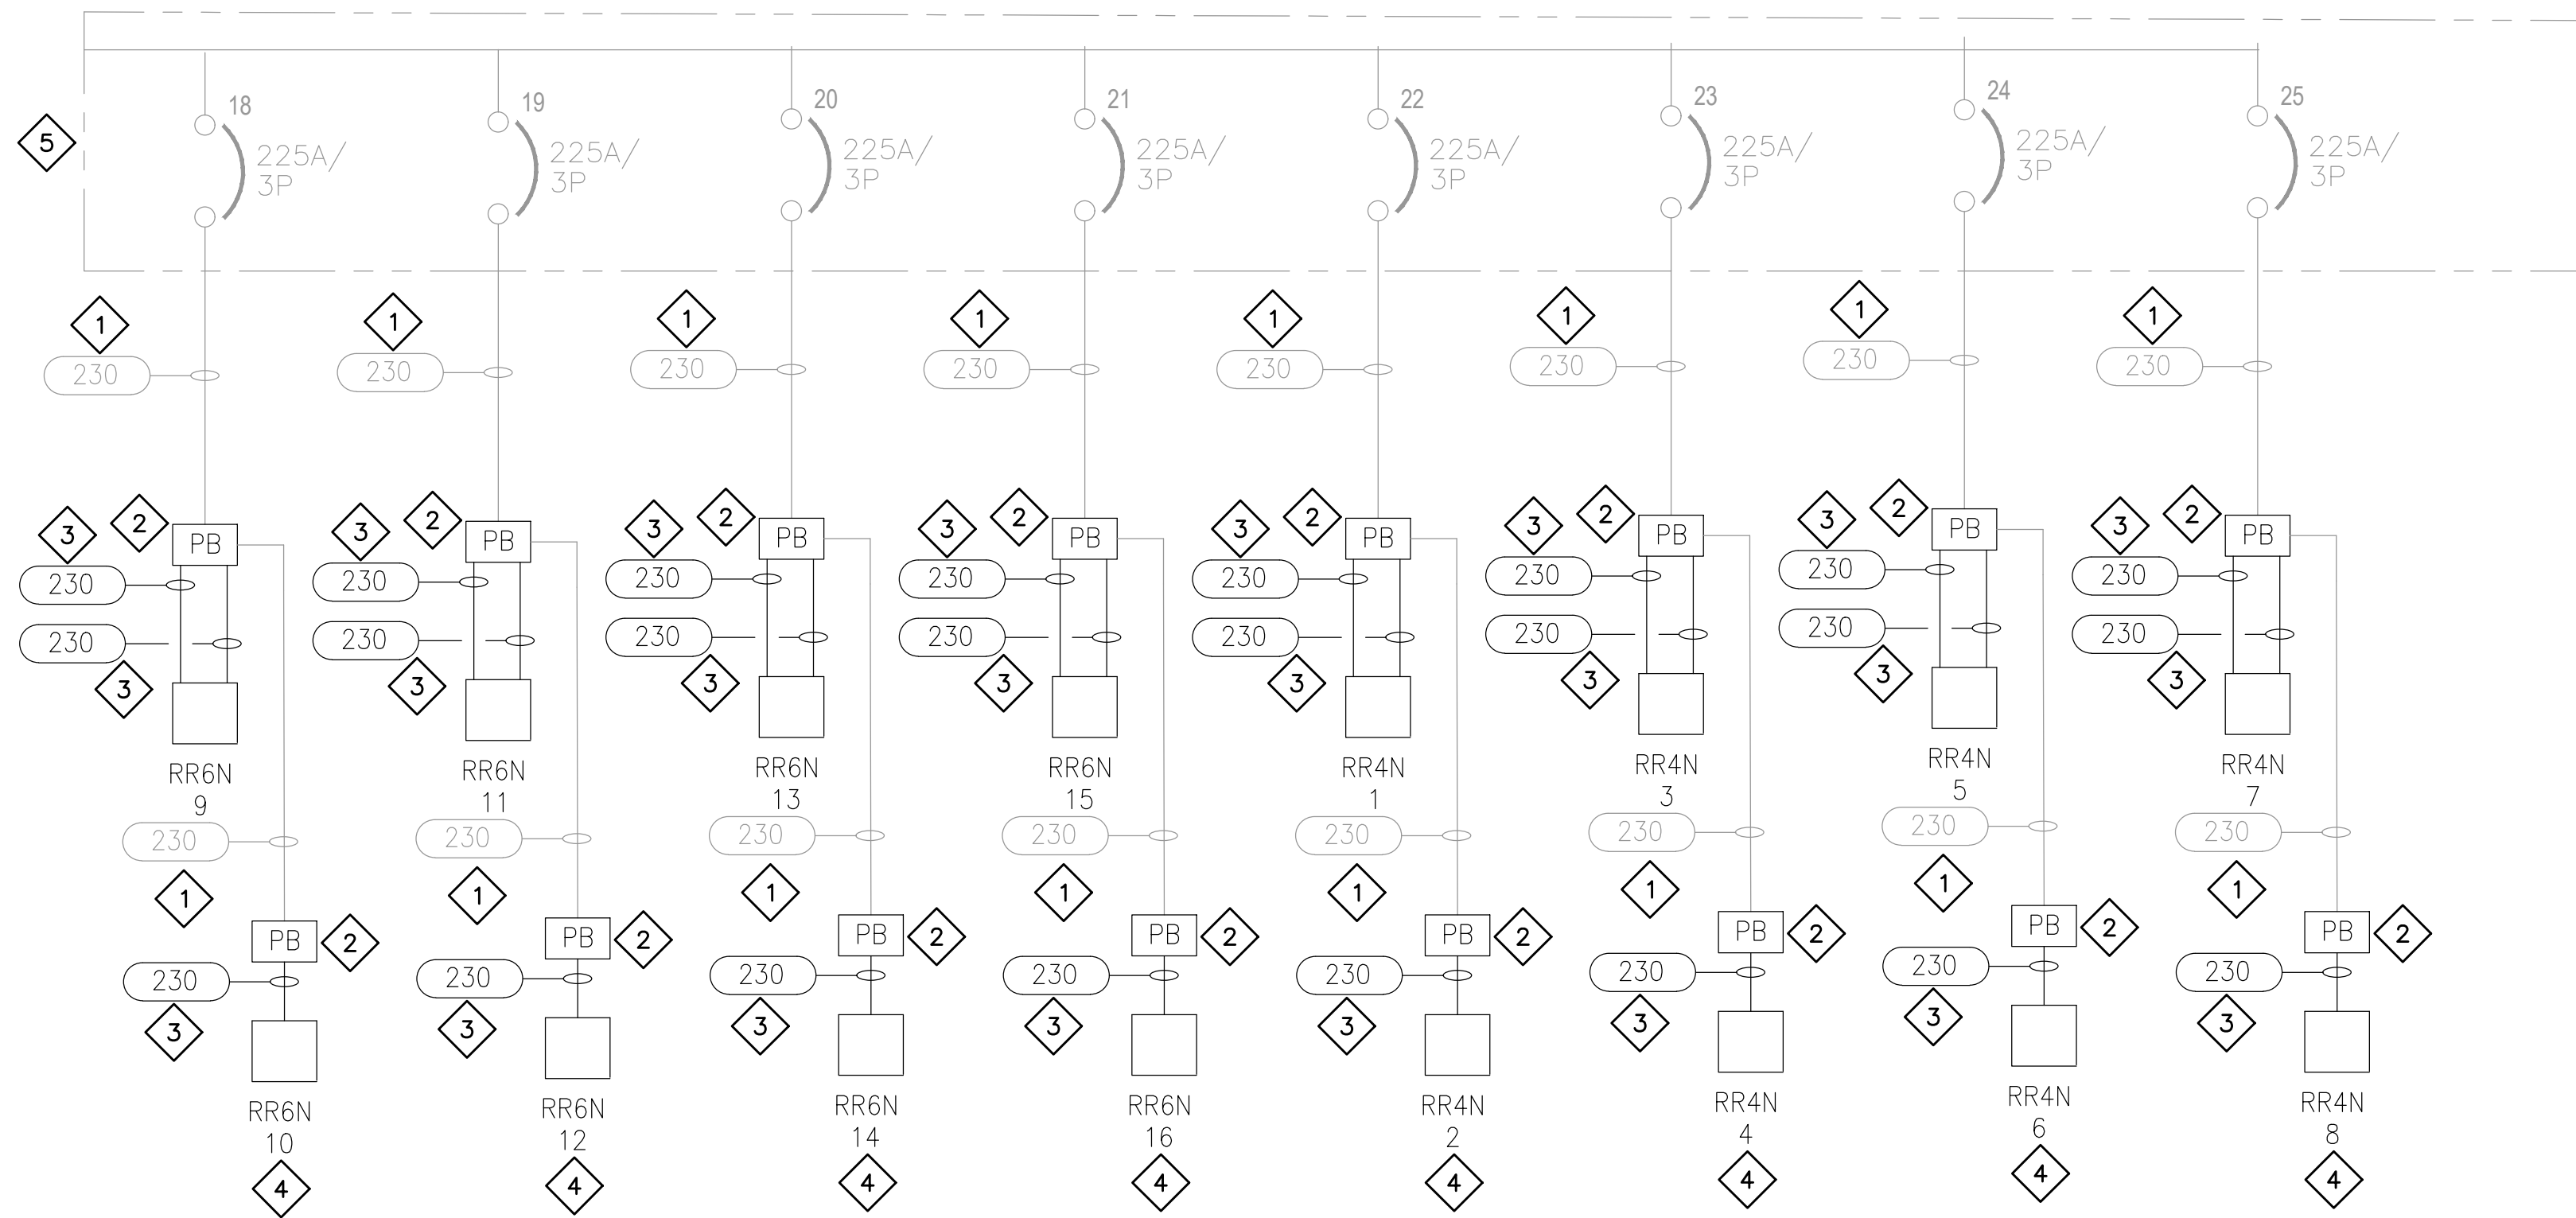

"Designed to Build"
 918 Howard Ave Suite F
 Biloxi, Mississippi 39530
 P: 228.388.1950
 www.mpdesigngroup.us
 David J. Machado, PE
 Brad P. Patano, PE
 Gerrod W. Kilpatrick, PE
 Bradford A. Jones, AIA
 Fernanda A. Silva, AIA

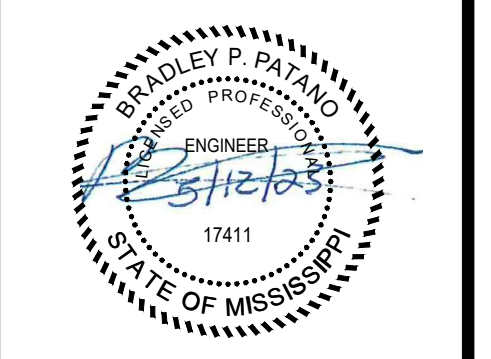

ELEVATED REEFER PLUGS
PORT OF GULFPORT MISSISSIPPI
STATE PORT AUTHORITY
 30TH AVENUE
 GULFPORT, MS 39501

SCALE: NOT TO SCALE
 PROJECT NO: 0297.22.002
 DRAWN BY: KDB
 CHECKED BY: KDB

ELECTRICAL ONE-LINE DIAGRAM

NO.	DATE	REVISION / SUBMITTAL
REV 0	4/13/2023	ISSUED FOR CONSTRUCTION
REV 1	5/12/2023	ADDENDUM 1


E604
 VERIFY SCALES
 BAR IS ONE INCH ON ORIGINAL DRAWING
 IF NOT ONE INCH ON THIS SHEET, ADJUST SCALES ACCORDINGLY

THE ORIGINAL SIGNED, DATED AND SEALED ENGINEERING PLANS ARE THE OFFICIAL DOCUMENTS SUBMITTED TO THE APPROVING AUTHORITY FOR THESE PLANS. CONTRACTOR / SUBCONTRACTOR / AND/OR OWNER SHALL CONSULT ENGINEERED PLANS TO VERIFY ANY CONDITIONS OR RESTRICTIONS THAT MAY HAVE BEEN REQUIRED BY THE APPROVING AUTHORITY OR APPROVED BY THE REGISTERED ENGINEER OF RECORD. IF DISCREPANCIES OCCUR, THE ORIGINAL SIGNED, DATED AND SEALED ENGINEERED PLAN SET SHALL OVERRIDE ANY OTHER PLANS, THE DRAWINGS, DETAILS, AND NOTES THAT APPEAR ON THIS SHEET ARE COPYRIGHTED BY MACHADO | PATANO, PLLC, AND CLAIM ALL RIGHTS OF THE COPYRIGHT LAWS. © COPYRIGHTED MATERIAL

PRINTED: 5/12/2023 1:50 PM BY: Kenneth Beverin LAST SAVED: 5/12/2023 1:38 PM BY: Kbeverin
 m:\0297_mspa_gulfport\0297.22.003_work_order no 2 - reefer plug replacement & mitigation\06-electrical\02-production\01-production drawings\port of gulfport reefer plugs electrical.dwg

TO
UTILITY
TRANSFORMERS

4180N
 MSB-16A (SECTION 1 & SECTION 2 PARTIAL)
 480/277V, 3Ø, 4W,
 4,000A MCB, 65,000 AIC, NEMA 3R
 LOCATION: PLATFORM 16, TOTAL CONNECTED LOAD = UNKNOWN

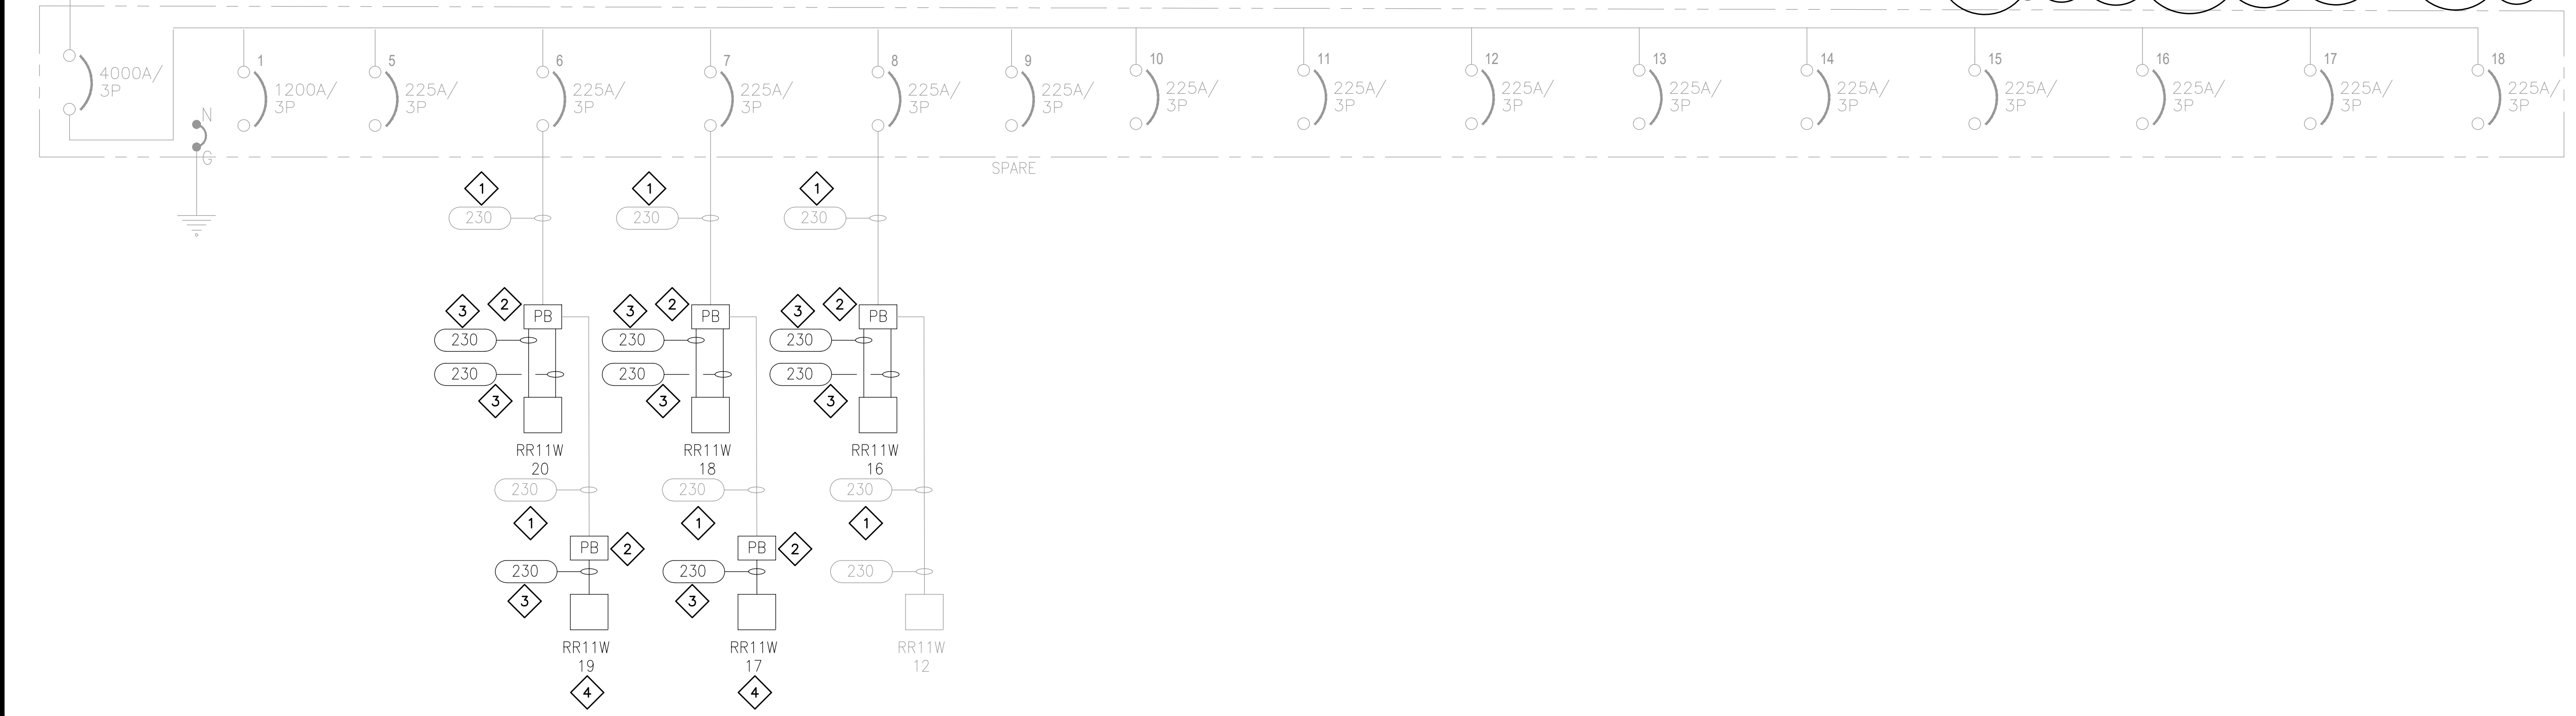


SHEET E605 LEGEND


230 - 3-#3/0 AWG + 1-#4 AWG (G) XHHW-2 TYPE TC CONDUCTOR

DRAWING E605 SPECIFIC NOTES

- 1 EXISTING FEEDER TO REMAIN AS-IS.
- 2 CONTRACTOR SHALL PROVIDE AND INSTALL PULLBOX/SPLICE BOX. SEE SHEET E501 FOR DETAILS.
- 3 CONTRACTOR SHALL EXTEND FEEDER TO NEW ELEVATED REEFER OUTLET. NEW CONDUCTOR SHALL BE ROUTED IN RGS CONDUIT. SPLICES SHALL BE MADE WATER-TIGHT. SEE SHEET E501 FOR DETAILS.
- 4 NEW REEFER OUTLETS (PROVIDED BY OWNER, INSTALLED BY CONTRACTOR) SHALL BE ON ELEVATED PLATFORM. CONTRACTOR SHALL NOTE THAT MULTIPLE REEFER OUTLETS ARE ON A SINGLE CIRCUIT. SEE CIVIL/STRUCTURAL SHEETS FOR PLATFORM DETAILS. PLATFORMS SHALL BE PROVIDED AND INSTALLED BY CONTRACTOR.

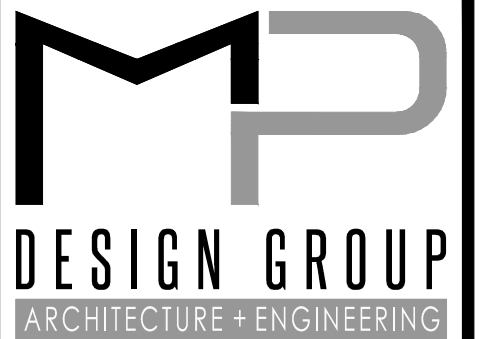

"Designed to Build"
 918 Howard Ave Suite F
 Biloxi, Mississippi 39530
 P: 228.388.1950
 www.mpdesigngroup.us
 David J. Machado, PE
 Brad P. Patano, PE
 Gerrod W. Kilpatrick, PE
 Bradford A. Jones, AIA
 Fernanda A. Silva, AIA

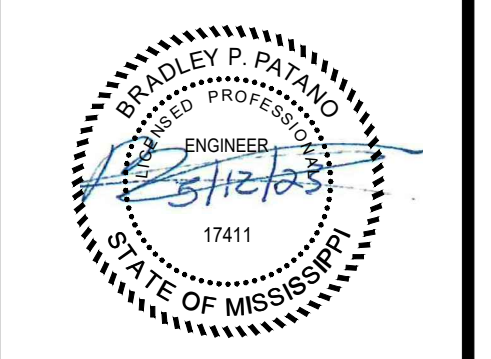

ELEVATED REEFER PLUGS
PORT OF GULFPORT MISSISSIPPI
STATE PORT AUTHORITY
 30TH AVENUE
 GULFPORT, MS 39501

SCALE: NOT TO SCALE
 PROJECT NO: 0297.22.002
 DRAWN BY: KDB
 CHECKED BY: KDB

ELECTRICAL ONE-LINE DIAGRAM

NO.	DATE	REVISION / SUBMITTAL
REV 0	4/13/2023	ISSUED FOR CONSTRUCTION
REV 1	5/12/2023	ADDENDUM 1

E605
 VERIFY SCALES
 BAR IS ONE INCH ON ORIGINAL DRAWING
 IF NOT ONE INCH ON THIS SHEET, ADJUST SCALES ACCORDINGLY

THE ORIGINAL SIGNED, DATED AND SEALED ENGINEERING PLANS ARE THE OFFICIAL DOCUMENTS SUBMITTED TO THE APPROVING AUTHORITY FOR THESE PLANS. CONTRACTOR / SUBCONTRACTOR / AND/OR OWNER SHALL CONSULT ENGINEERED PLANS TO VERIFY ANY CONDITIONS OR RESTRICTIONS THAT MAY HAVE BEEN REQUIRED BY THE APPROVING AUTHORITY OR APPROVED BY THE REGISTERED ENGINEER OF RECORD. IF DISCREPANCIES OCCUR, THE ORIGINAL SIGNED, DATED AND SEALED ENGINEERED PLAN SET SHALL OVERRIDE ANY OTHER PLANS, THE DRAWINGS, DETAILS, AND NOTES THAT APPEAR ON THIS SHEET ARE COPYRIGHTED BY MACHADO | PATANO, PLLC, AND CLAIM ALL RIGHTS OF THE COPYRIGHT LAWS. © COPYRIGHTED MATERIAL

**SECTION 055000
METAL FABRICATIONS**

PART 1 GENERAL

1.01 SECTION INCLUDES

- A. Shop fabricated steel items.

1.02 RELATED REQUIREMENTS

- A. Section 033000 - Cast-in-Place Concrete: Placement of metal fabrications in concrete.

1.03 REFERENCE STANDARDS

- A. ASTM A36/A36M - Standard Specification for Carbon Structural Steel 2019.
 B. ASTM A283/A283M - Standard Specification for Low and Intermediate Tensile Strength Carbon Steel Plates 2018.
 C. ASTM A307 - Standard Specification for Carbon Steel Bolts, Studs, and Threaded Rod 60 000 PSI Tensile Strength 2021.
 D. ASTM A501/A501M - Standard Specification for Hot-Formed Welded and Seamless Carbon Steel Structural Tubing 2021.
 E. AWS D1.1/D1.1M - Structural Welding Code - Steel 2020, with Errata (2022).
 F. SSPC-Paint 20 - Zinc-Rich Coating (Type I - Inorganic, and Type II - Organic) 2019.

1.04 SUBMITTALS

- A. See Section 013000 - Administrative Requirements, for submittal procedures.
 B. Shop Drawings: Indicate profiles, sizes, connection attachments, reinforcing, anchorage, size and type of fasteners, and accessories. Include erection drawings, elevations, and details where applicable. Provide templates for anchors and bolts specified for installation under other Sections. Provide reaction loads for each hanger and bracket.

PART 2 PRODUCTS

2.01 MATERIALS - STEEL

- A. Steel Sections: ASTM A36/A36M.
 B. Steel Tubing: ASTM A501/A501M hot-formed structural tubing.
 C. Plates: ASTM A283/A283M.
 D. Bolts, Nuts, and Washers: Stainless Steel 316
 E. Welding Materials: AWS D1.1/D1.1M; type required for materials being welded.

2.02 FABRICATION

- A. Fit and shop assemble items in largest practical sections, for delivery to site.
 B. Fabricate items with joints tightly fitted and secured.
 C. Grind exposed joints flush and smooth with adjacent finish surface. Make exposed joints butt tight, flush, and hairline. Ease exposed edges to small uniform radius.
 D. Furnish components required for anchorage of fabrications. Fabricate anchors and related components of same material and finish as fabrication, except where specifically noted otherwise.

2.03 FINISHES - STEEL

- A. Clean surfaces of rust, scale, grease, and foreign matter prior to finishing.
 B. Steel should be blasted in accordance with Dry Abrasive Blast SSPC SP10 at minium.
 C. Paint:
 1. Option 1: BLP
 a. One (1) Primer Coat: BLP Mobile MoPoxY ZRV Zinc Rich Epoxy @ 3.0 dft.
 b. One (1) Intermediate Coat: BLP Mobile Paints MoPoxY ST Epoxy Coating @ 6.0 dft.

- c. One (1) Finish Coat: BLP Mobile Paints MOTHANE Polyurethane @ 2.0 dft. Color to be selected by owner.
2. Option 2: Sherwin Williams Paint System
 - a. One (1) Primer Coat: SW Zinc Clad 4100 Organic Zinc-Rich Epoxy Primer @ 3.0 dft.
 - b. One (1) Intermediate Coat: SW Recoatable Epoxy Primer @ 6.0 dft.
 - c. One (1) Finish Coat: SW Acrolon 218 HS Acrylic Polyurethane @ 2.0 dft. Color to be selected by owner.

2.04 FABRICATION TOLERANCES

- A. Squareness: 1/8 inch maximum difference in diagonal measurements.
- B. Maximum Offset Between Faces: 1/16 inch.
- C. Maximum Misalignment of Adjacent Members: 1/16 inch.
- D. Maximum Bow: 1/8 inch in 48 inches.
- E. Maximum Deviation From Plane: 1/16 inch in 48 inches.

PART 3 EXECUTION

3.01 EXAMINATION

- A. Verify that field conditions are acceptable and are ready to receive work.

3.02 PREPARATION

- A. Supply setting templates to the appropriate entities for steel items required to be embedded in concrete.

3.03 INSTALLATION

- A. Install items plumb and level, accurately fitted, free from distortion or defects.
- B. Provide for erection loads, and for sufficient temporary bracing to maintain true alignment until completion of erection and installation of permanent attachments.
- C. Obtain approval prior to site cutting or making adjustments not scheduled.

3.04 TOLERANCES

- A. Maximum Variation From Plumb: 1/4 inch.
- B. Maximum Offset From True Alignment: 1/4 inch.
- C. Maximum Out-of-Position: 1/4 inch.

END OF SECTION